


R-3207
28576

T. 1 N. R. 12 E. W. M.

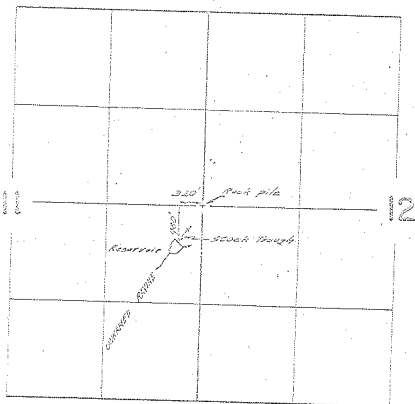

FINAL PROOF SURVEY
UNDER

A-58217 R-3207
Application No. 38313 Permit No. 28576
IN NAME OF

C S TRYGG

Surveyed June 16 1967, by J. J. Figgert