


R-3207
28576

T. 1 N. R. 12 E. W. M.

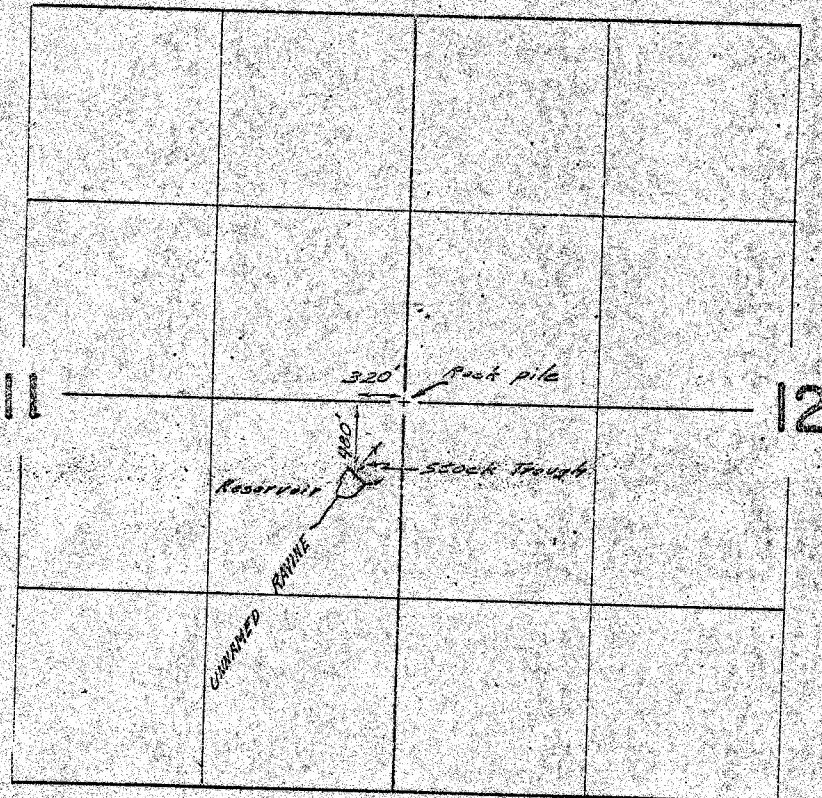

FINAL PROOF SURVEY
UNDER

R-38217 R-3207
Application No. 30313. Permit No. 28576
IN NAME OF

C. S. TRYGG

Surveyed June 16 1967, by W. J. Figgert