


29270

T. 2 N. R. 118. 12 E. W. M.

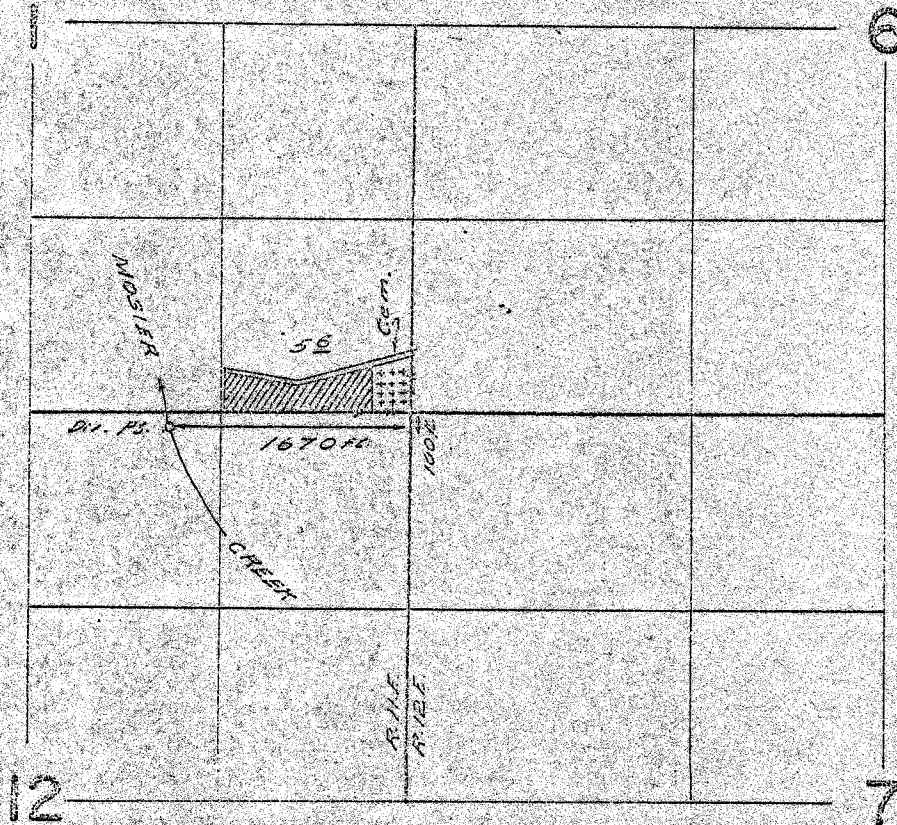

FINAL PROOF SURVEY
UNDER

Application No. 39301 Permits No. 29270
IN NAME OF

*William L. & Gertrude Louise
Leininger*

Surveyed July 21, 1952, by *W. H. Ruppert*