


T.4S.R.2E.W.M.

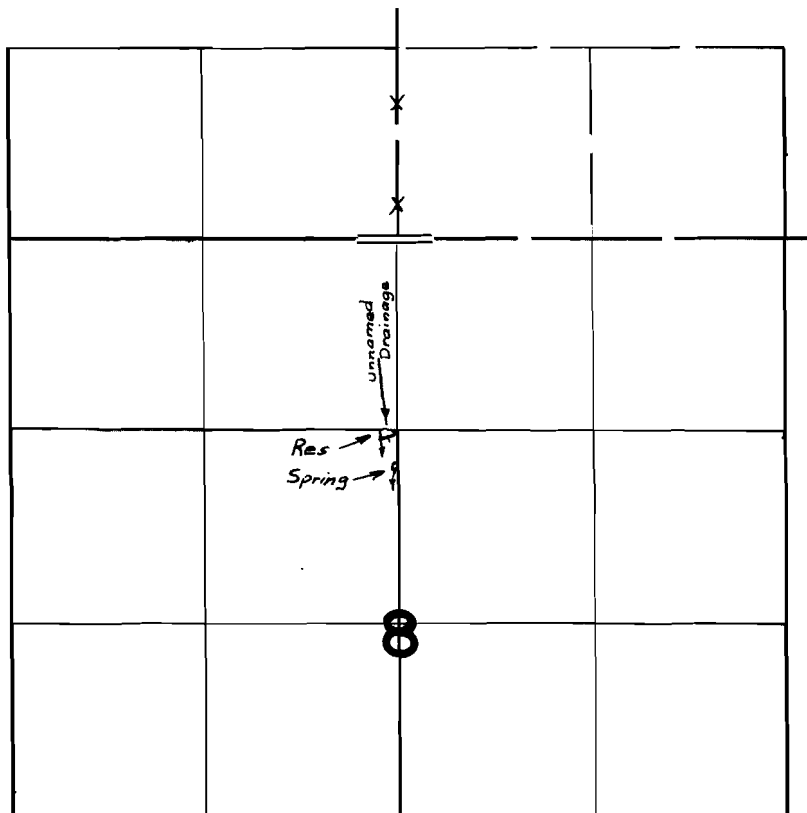

Spring located 10' W & 1550' S from N $\frac{1}{4}$ Cor Sec. 8
Dam located 50' W & 1350' S from N $\frac{1}{4}$ Cor Sec. 8

FINAL PROOF SURVEY
UNDER

Application No. R-39096 Permit No. R-3871
39097 29175
IN NAME OF

Walter V. Kearney

Surveyed Oct 19 1967, by W. J. Ruppert