
T.4S.R.2E.W.M.

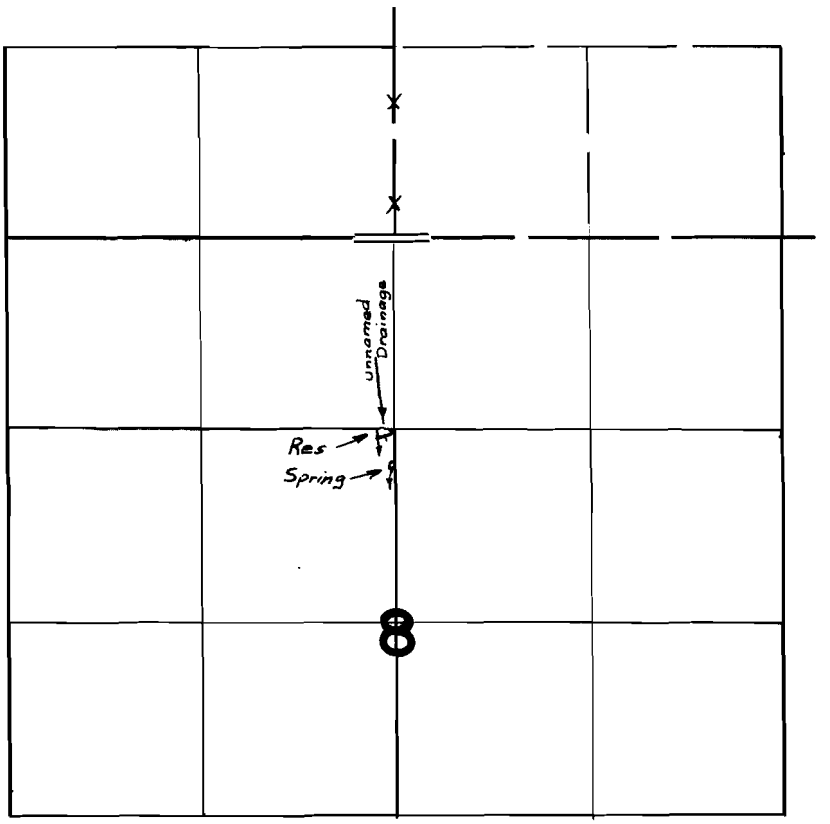

Spring located 10'W & 1550'S from N¼ Cor Sec. 8
Dam located 50'W & 1350'S from N¼ Cor Sec. 8

FINAL PROOF SURVEY
UNDER

Application No. R-39096 39097 Permit No. R-3871 29175

IN NAME OF

Walter V. Kearney

Surveyed Oct 19 19 67, by W.J. Ruppert

1967 Q GRO