


T.25&26 S.R.6&7 W.W.M.

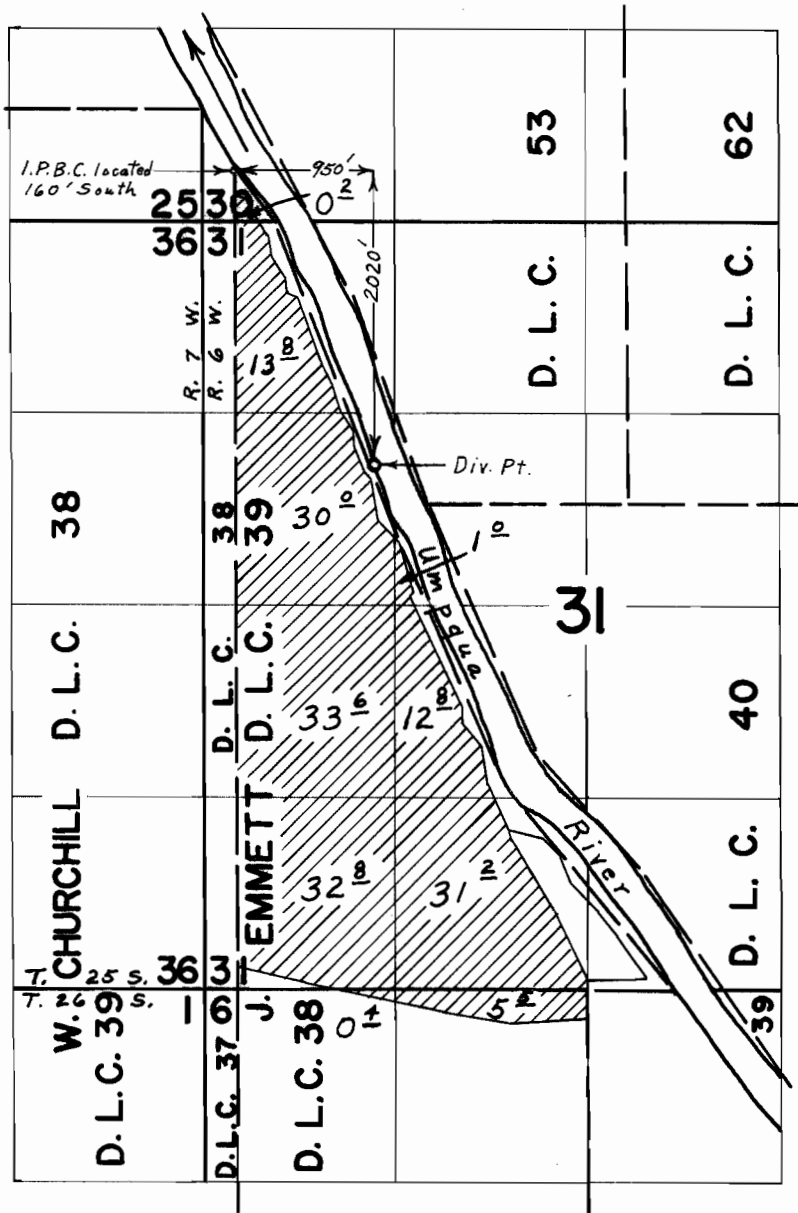

FINAL PROOF SURVEY
UNDER

Application No. 38421 Permit No. 28615
IN NAME OF

JAMES A. & MARY JANE BANDUCCI

Surveyed June 7, 1967, by L. E. Gould