


T. 28 S. R. 11 W. W. M.

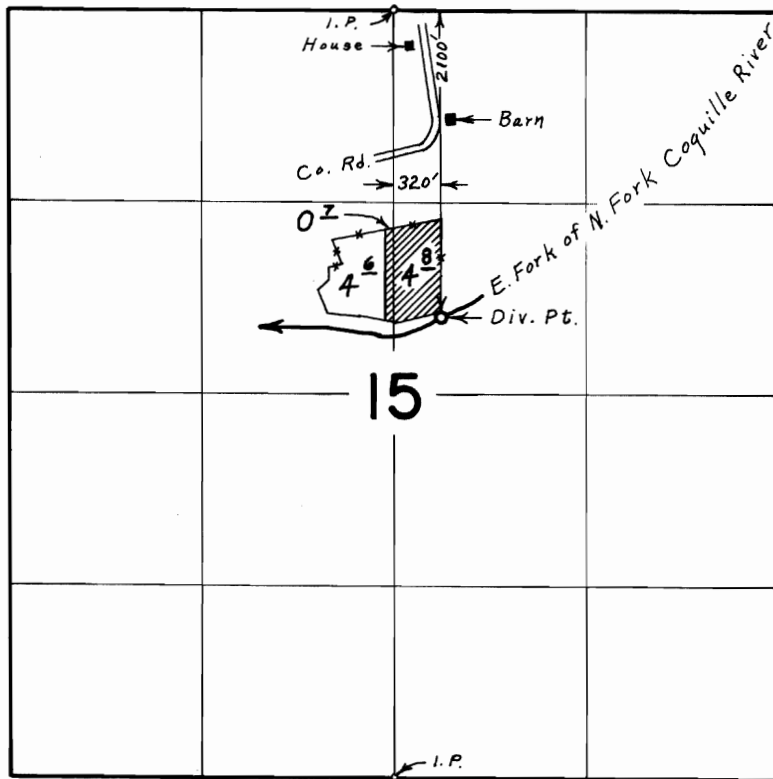

FINAL PROOF SURVEY
UNDER

Application No. 39477 Permit No. 29307
IN NAME OF

MERLIN E. OR VERAL LONG

Surveyed May 20, 1967, by L. E. Gould