


T. 28 S. R. 12 W. W.M.

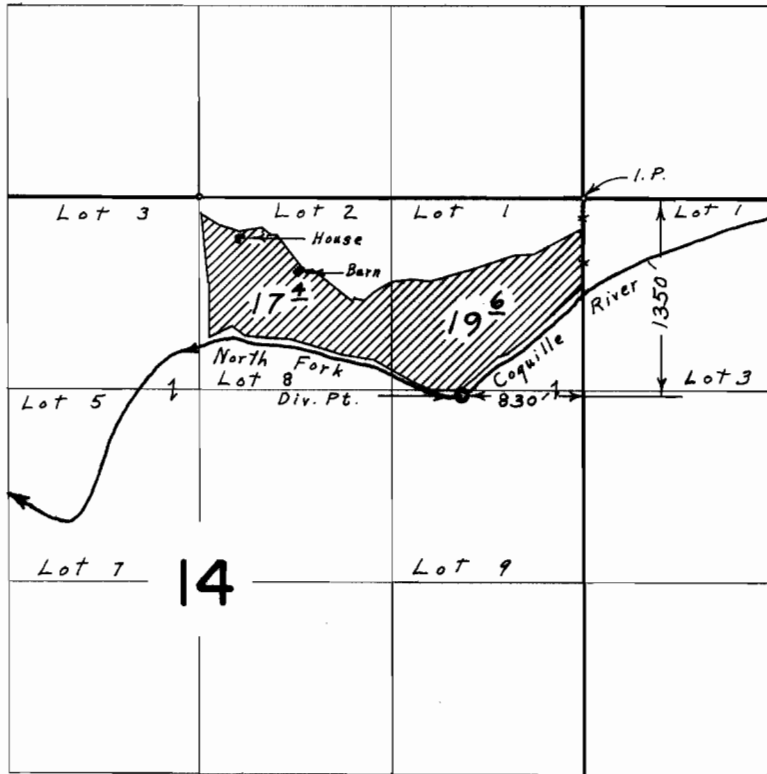

FINAL PROOF SURVEY
UNDER

Application No. 39512 Permit No. 29402
IN NAME OF

DONALD K. LAIRD

Surveyed May 24, 1967. by L. E. Gould