


T.29S.R.11W.W.M.

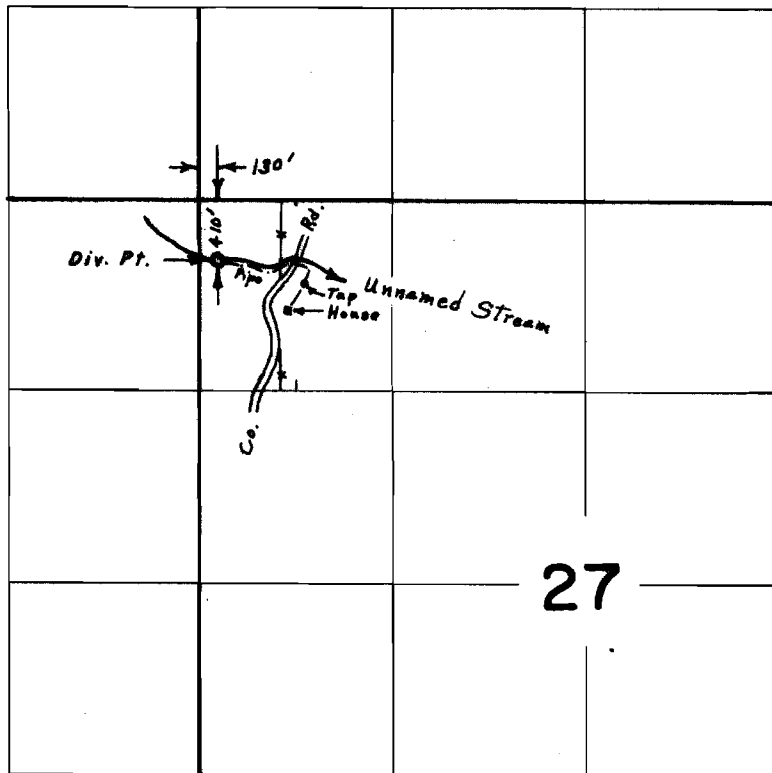

FINAL PROOF SURVEY
UNDER

Application No. 42000 Permit No. 3/431...
IN NAME OF

OSCAR O. & HATTIE E. JOHNSON

Surveyed May 15, 1967, by L. E. Gould...