


T. 27 & 28 S. R. 11 W. W. M.

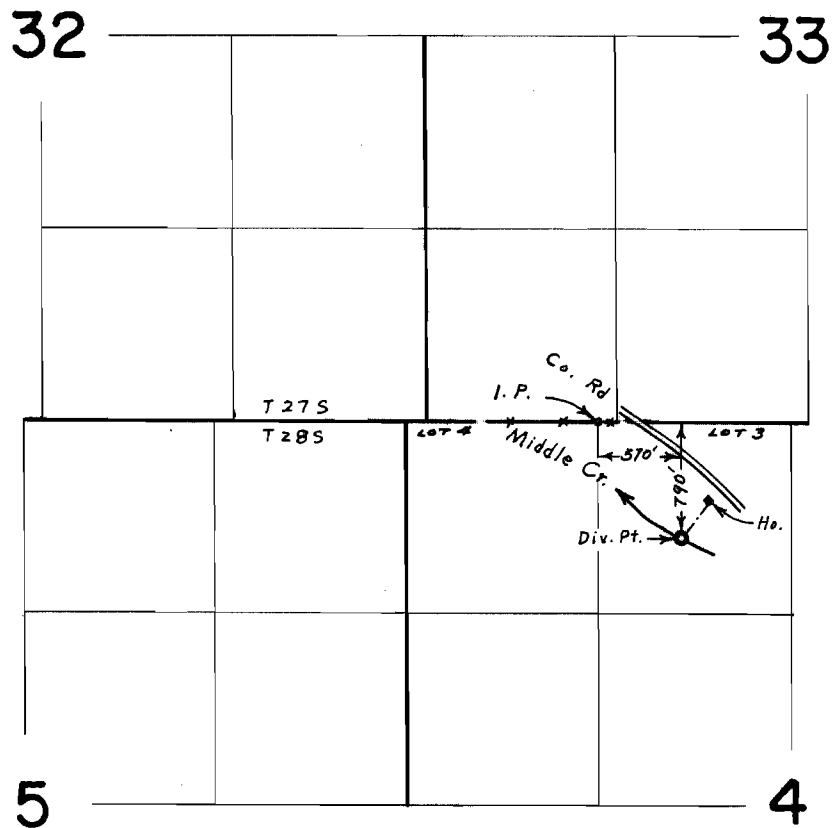

FINAL PROOF SURVEY UNDER

Application No. 39484 Permit No. 29311
IN NAME OF

CLARENCE E. CHURCHILL

Surveyed May 18, 1967, by L. E. Gould