


T. 25 S. R. 5 & 6 W. W. M.

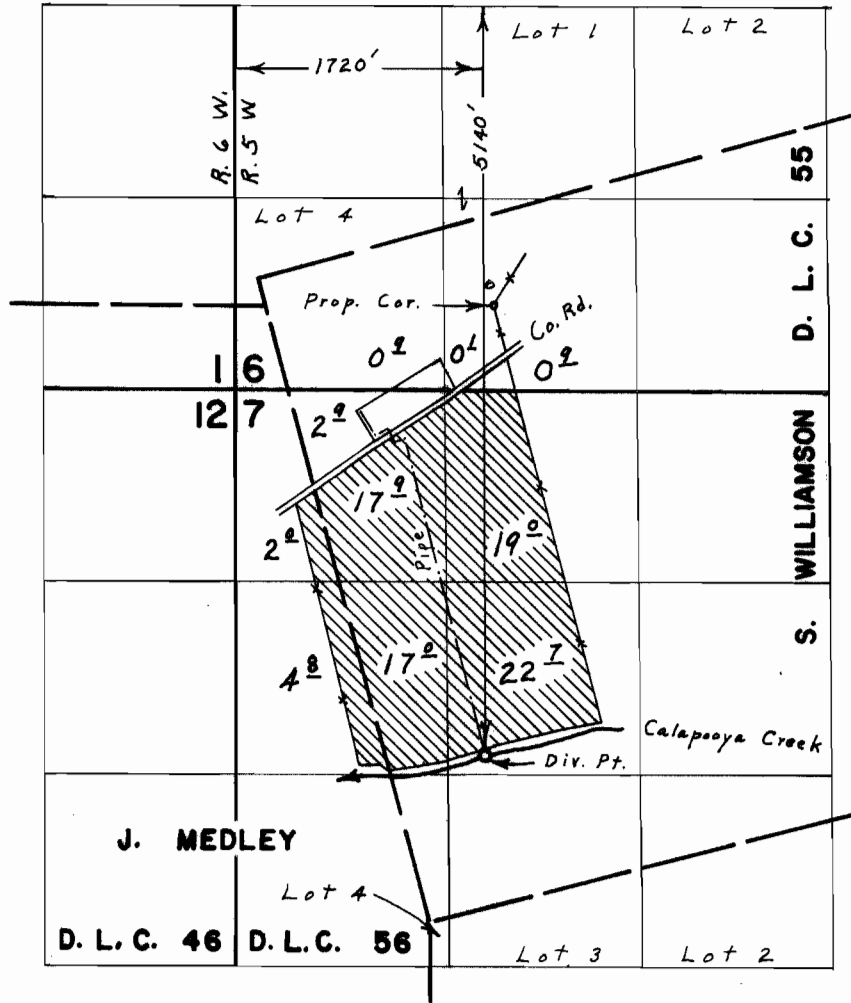

FINAL PROOF SURVEY UNDER

Application No. 39588 Permit No. 29421
IN NAME OF

DONALD P. BARRETT

Surveyed June 14, 1967, by L. E. Gould