

UMPQUA NATIONAL FOREST
 NORTH UMPQUA DISTRICT
 HORSESHOE BEND WATER SYSTEM

S. 19, T. 26 S., R. 2 E., W.M.

Scale: 8" = 1 mile


18 17
 19 20

LEGEND

- EXISTING ROAD 
- POINT OF DIVERSION 
- WATER USE AREA 

WILLAMETTE
 MERIDIAN

SECTION 19

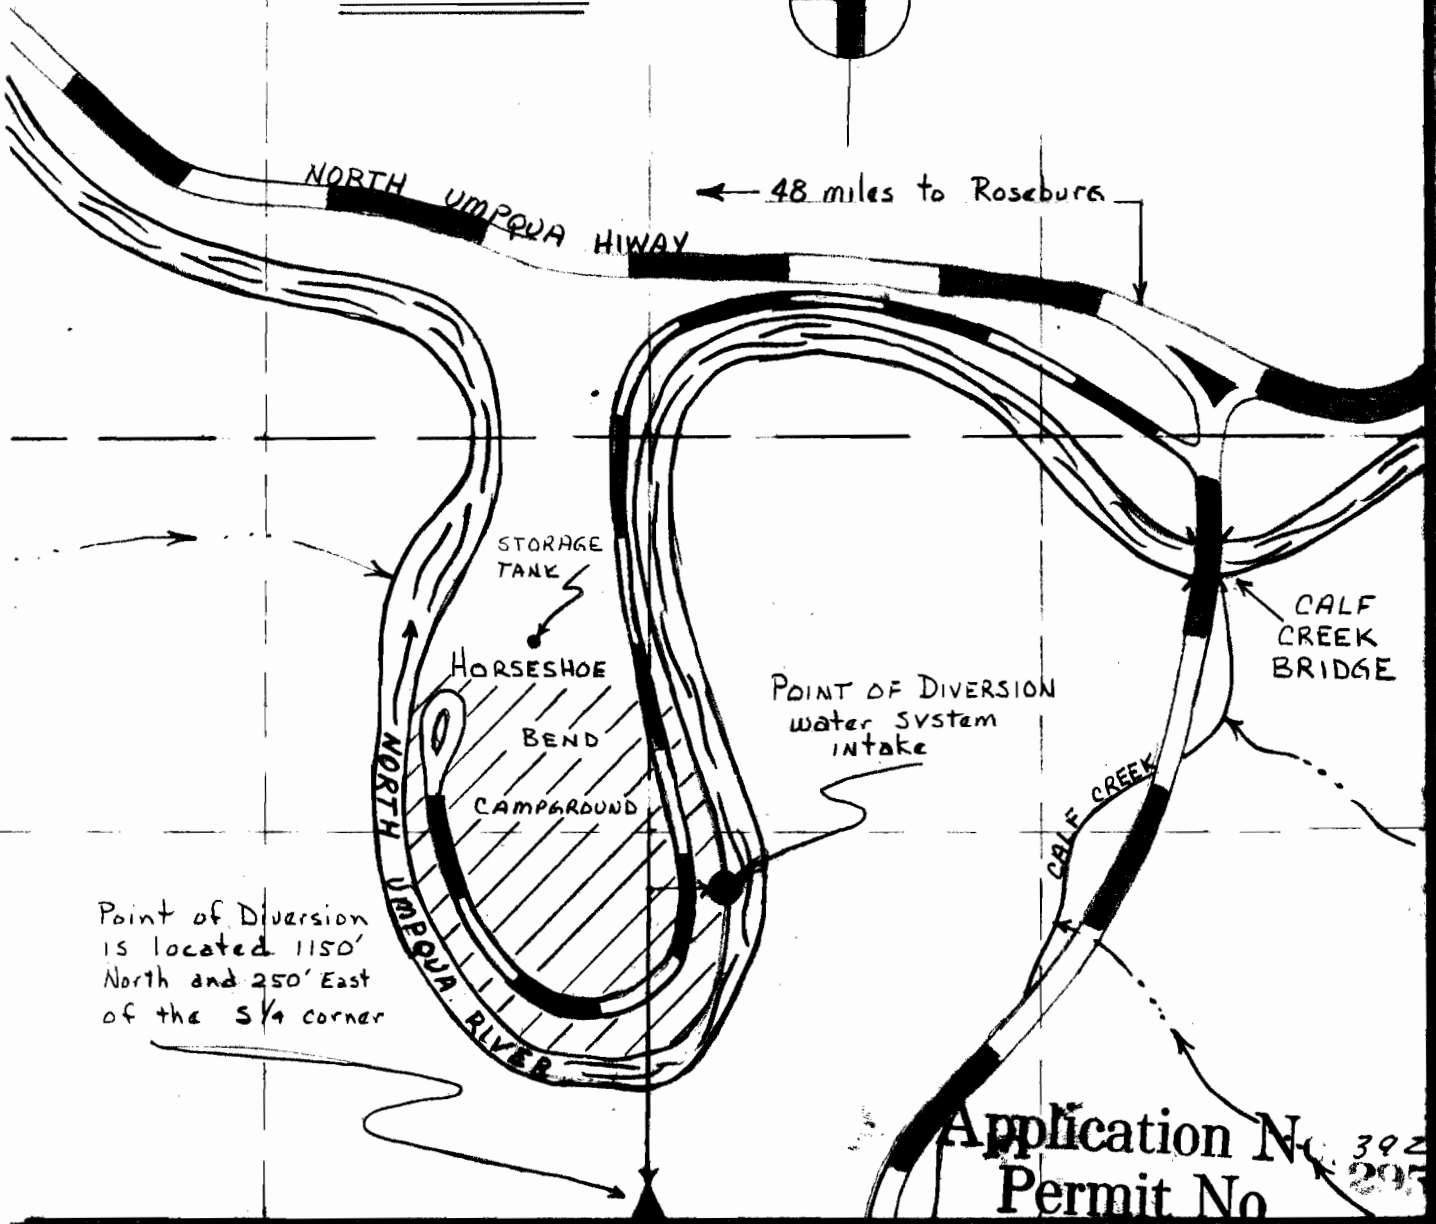

T.
 26
 S.

Point of Diversion
 is located 1150'
 North and 250' East
 of the S 1/4 corner

Application No. 39246
 Permit No. 29509

12-9-63
 R.D.H.

S 1/4
 CORNER

R. 2 E.