


T.24 S.R.5 W.W.M.

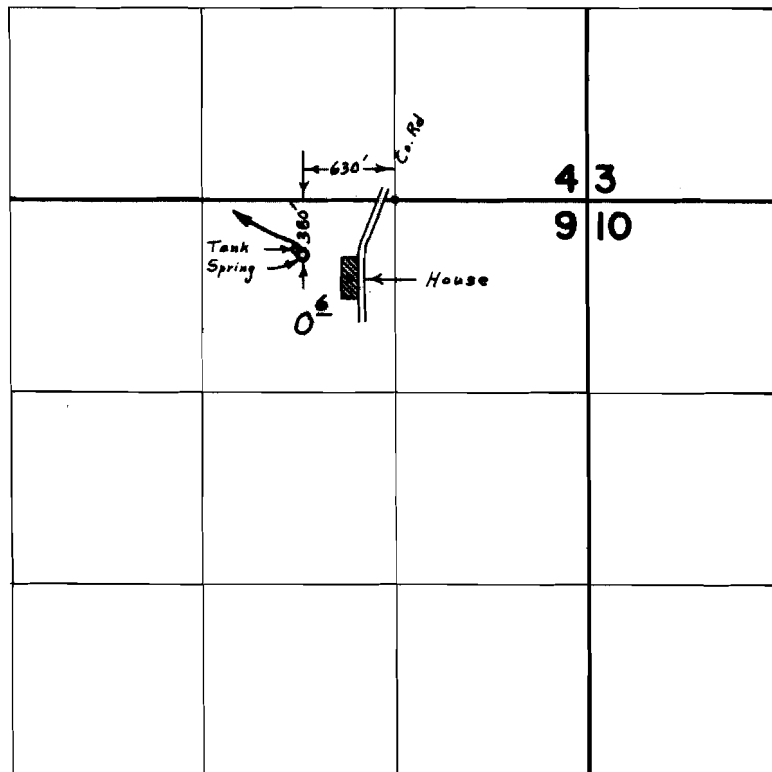

FINAL PROOF SURVEY
UNDER

Application No. 40855 Permit No. 30457
IN NAME OF

EMMITT CHURCHILL

Surveyed June 15, 1967, by L. E. Gould