


T.24 S.R.7 W.W.M.

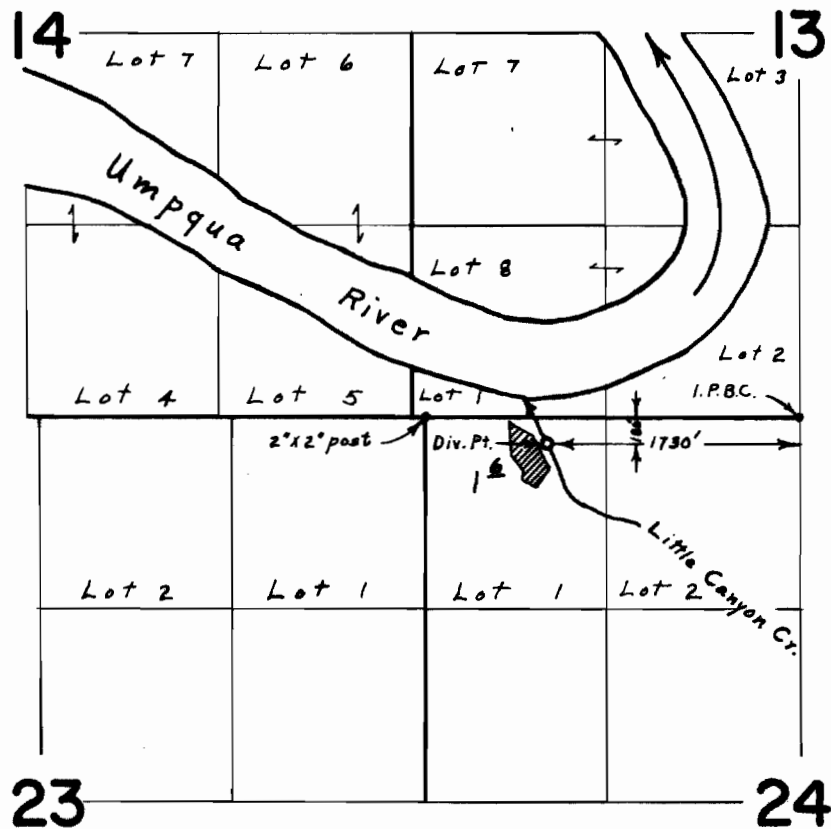

FINAL PROOF SURVEY
UNDER

Application No. 41331 Permit No. 30860
IN NAME OF
VICTOR HOWARD

Surveyed June 13, 1967, by L. E. Gould