


T.27 S.R.5 W. W.M.

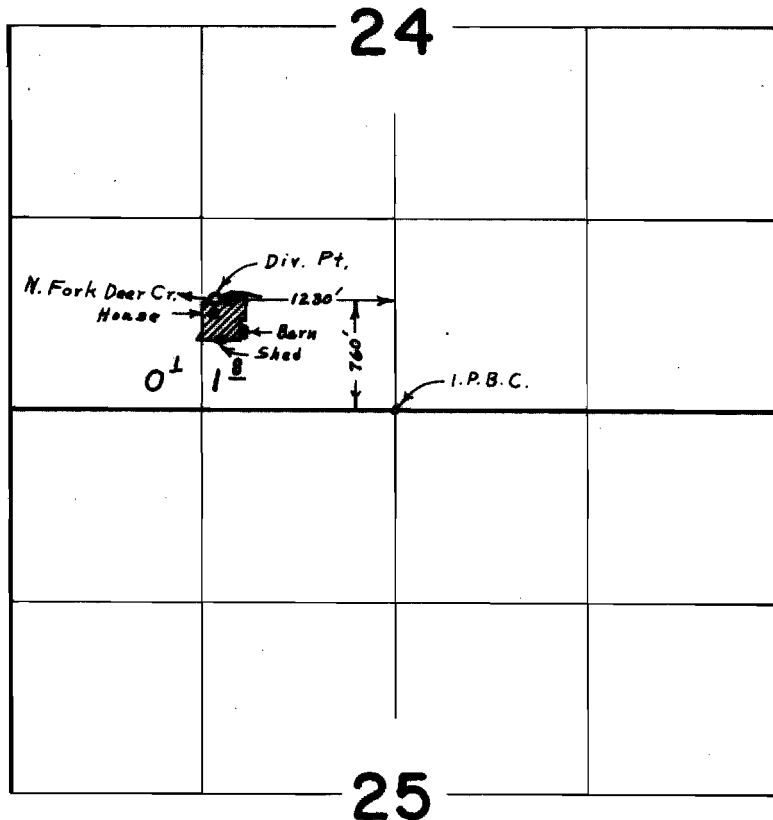

FINAL PROOF SURVEY
UNDER

Application No. 41564 Permit No. 31005
IN NAME OF
GEORGE W. JR., & DORIS RUTH JAMES

Surveyed June 12, 1967, by L. E. Gould