


T.33S.R.1W.W.M.

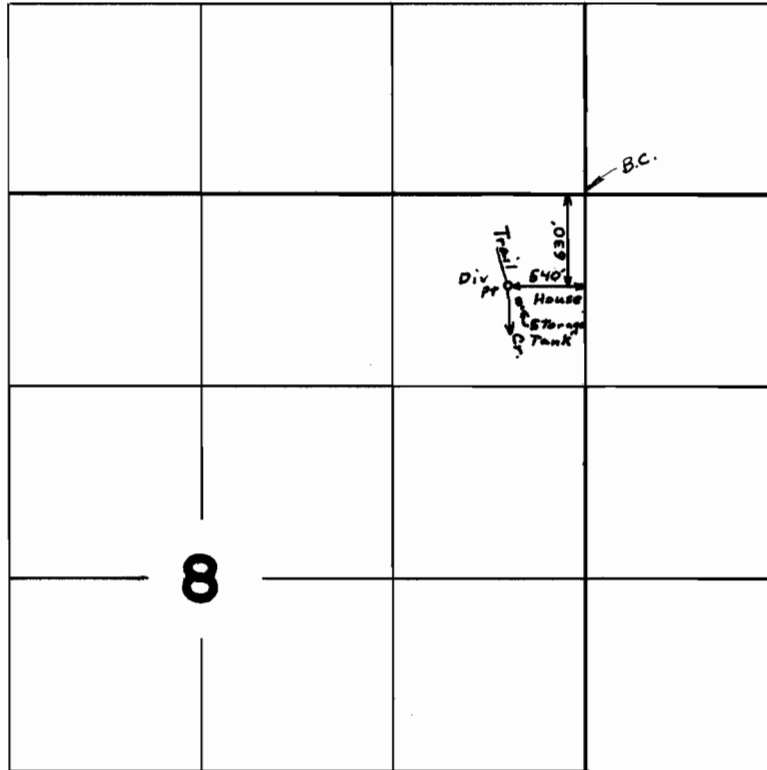

8

FINAL PROOF SURVEY UNDER

Application No. 38970 Permit No. 29036
IN NAME OF

Jay C. and Mary Jane Potvin

Surveyed May 22, 1967, by W. J. Ruppert