



T.33S.R.2E.W.M.

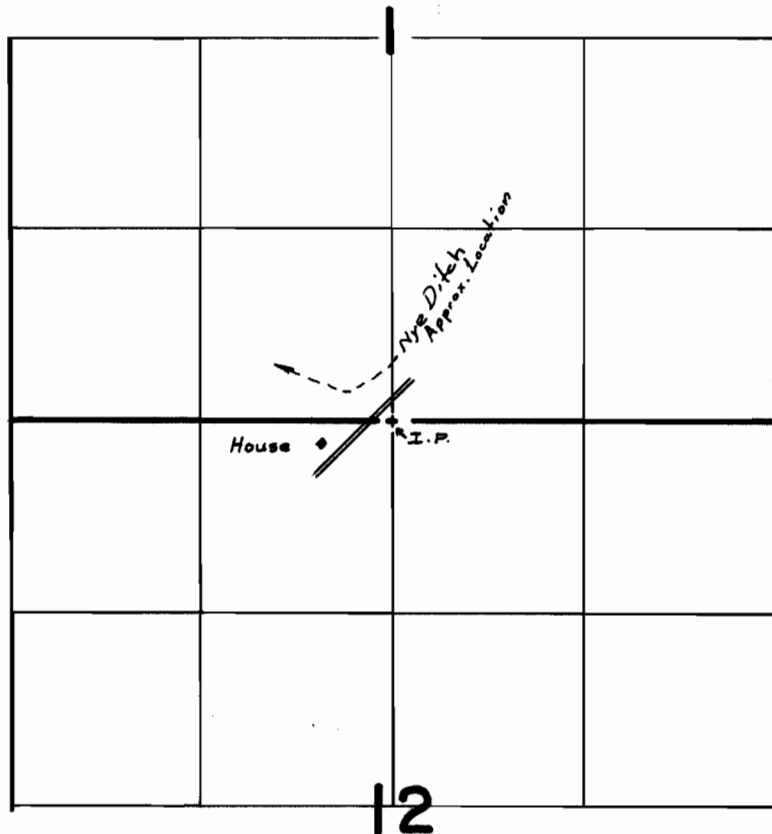

T.32S.R.3E.W.M.

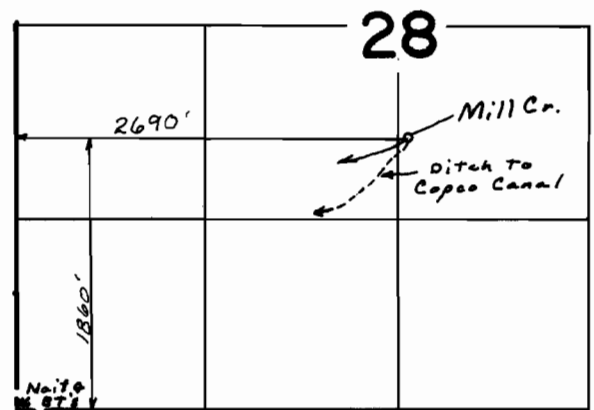

**FINAL PROOF SURVEY**  
UNDER

Application No. 38995 Permit No. 29049  
IN NAME OF

Loren & Eva Rusk

Surveyed May 22 1967, by W. J. Ruppert