


T.38S.R.4&5W.W.M.

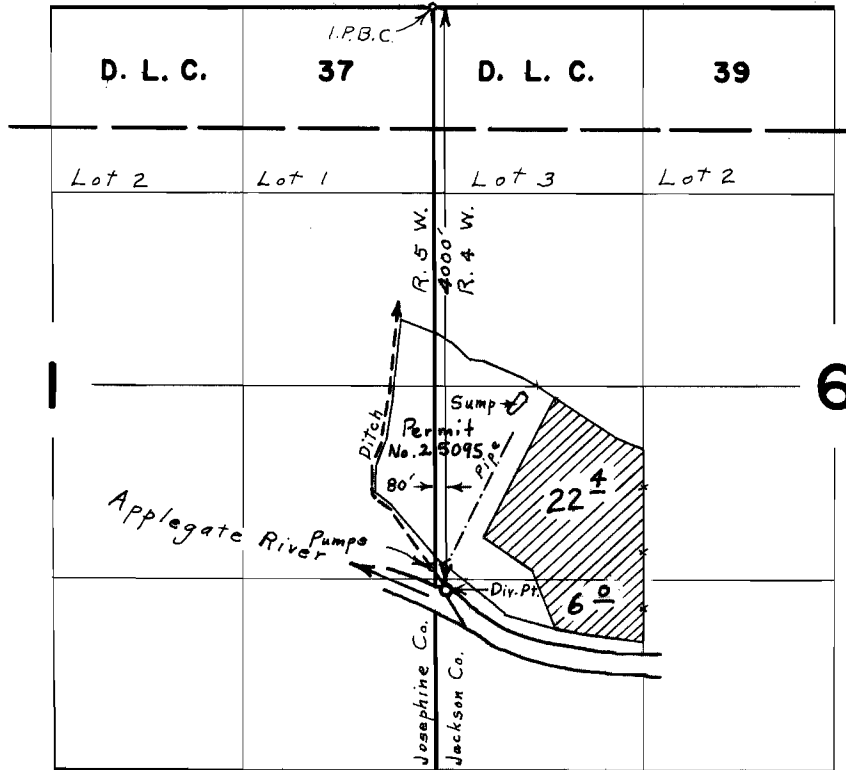

FINAL PROOF SURVEY UNDER

Application No. 39/22 Permit No. 29/77
IN NAME OF

BENNETT LOGGING CORPORATION

Surveyed July 31, 1967, by L. E. Gould