


T.33S.R.1E.W.M.

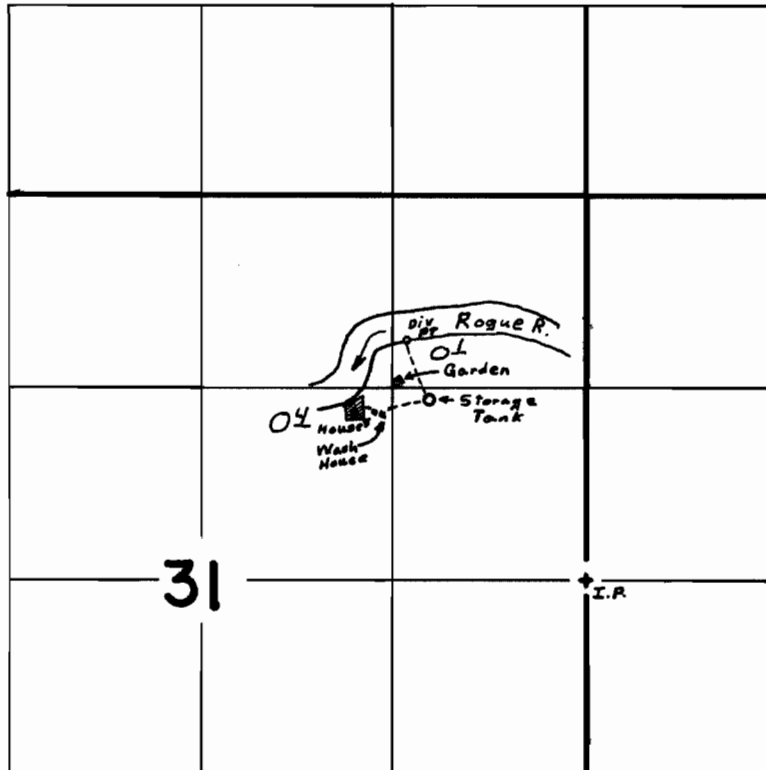

Div Pt located 1650ft N + 1240ft W from E 1/4 cor of Sec 31

FINAL PROOF SURVEY UNDER

Application No. 39272 Permit No. 29251
IN NAME OF

O. Gordon Hudson s/r Loyal F. Lust

Surveyed May 18 1967, by W. V. Ruppert