


T.36 S.R.3W.W.M.

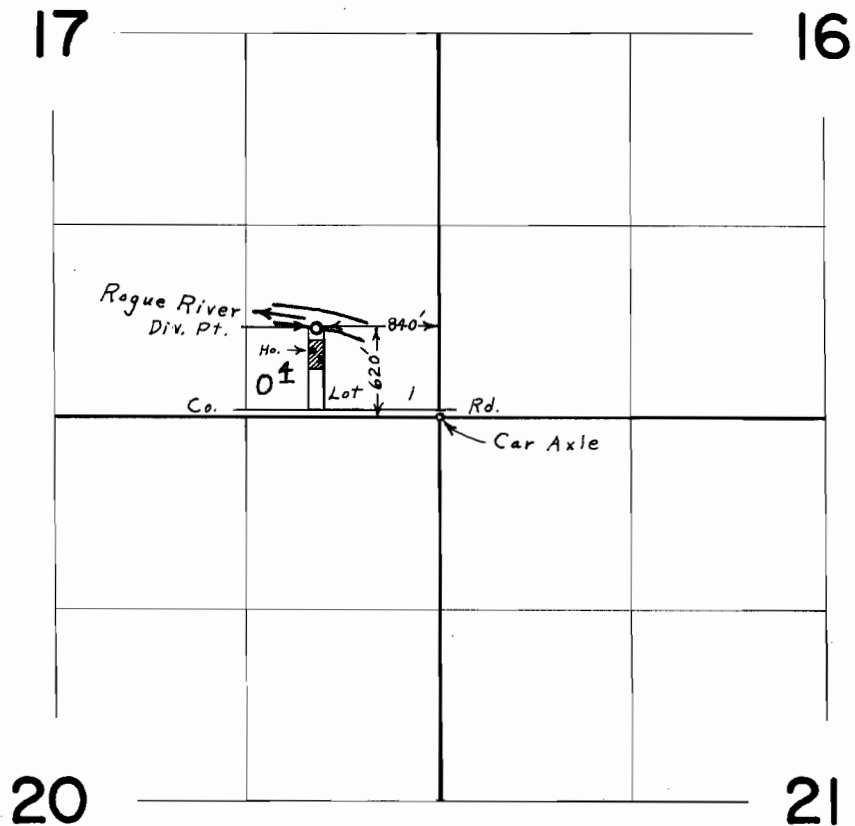

FINAL PROOF SURVEY
UNDER

Application No. 42336 Permit No. 31651

IN NAME OF

ARMOND B. CHASE

Surveyed July 27 1967, by L. E. Gould