


# T.13S.R.9E.W.M.

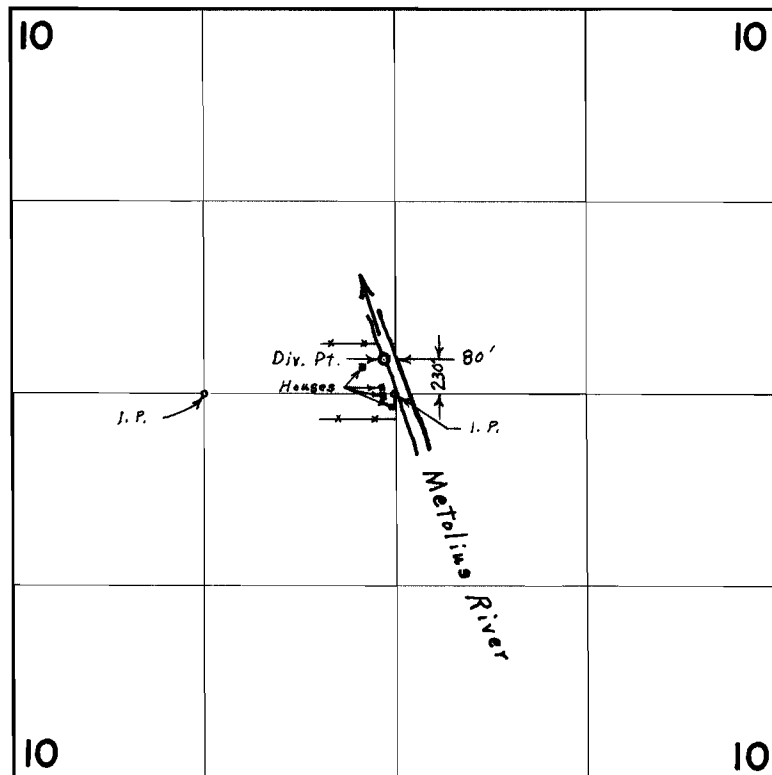

## FINAL PROOF SURVEY UNDER

Application No. 38724 Permit No. 28834  
IN NAME OF

**GENE GALLAHER**

Surveyed July 11, 1967, by L. E. Gould