


T.36 & 37 S.R.5 W.W.M.

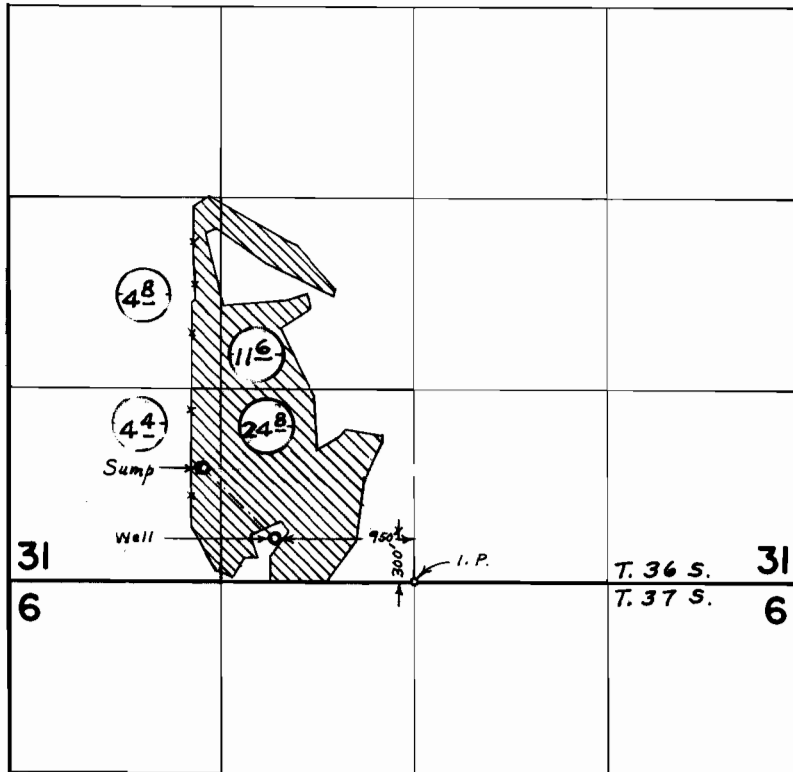

FINAL PROOF SURVEY UNDER

Application No. G-3358 Permit No. G-3151
 IN NAME OF
GRANTS PASS GOLF CLUB, INC.

Surveyed Aug. 28, 1967, by L. E. Gould