

R-3888
29225


38-5-21

T.38S.,R.5W.,W.M.

RECEIVED

NOV 24 1976

WM. DIST. 14
GRANTS PASS, ORE.

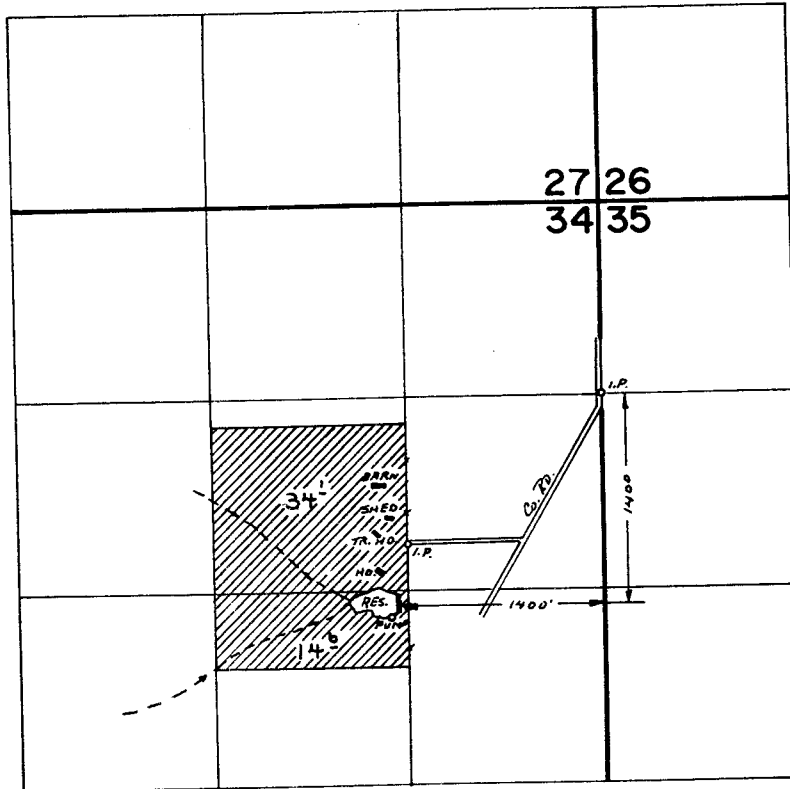

FINAL PROOF SURVEY
UNDER

Application No. **R-39196** 39197... Permit No. **R-3888** 29225...
IN NAME OF

.....**HERBERT I. MAGEE**.....

Surveyed Aug. 22, 1967, by L. E. Gould.....
SEPT. 19 1974 L. TOLL