


# T. 36 S. R. 6 W. W. M.

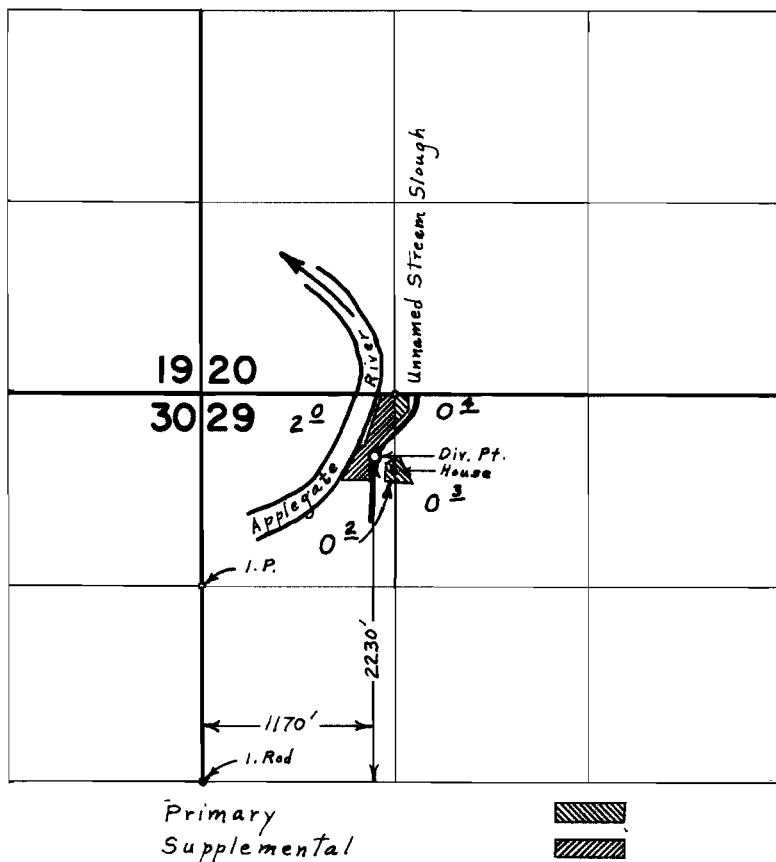

## FINAL PROOF SURVEY UNDER

Application No. 41360 Permit No. 30896  
 IN NAME OF  
**C. A. EIDE**

Surveyed Aug. 30, 1967, by L. E. Gould