


T.36 S.R.5 W.W.M.

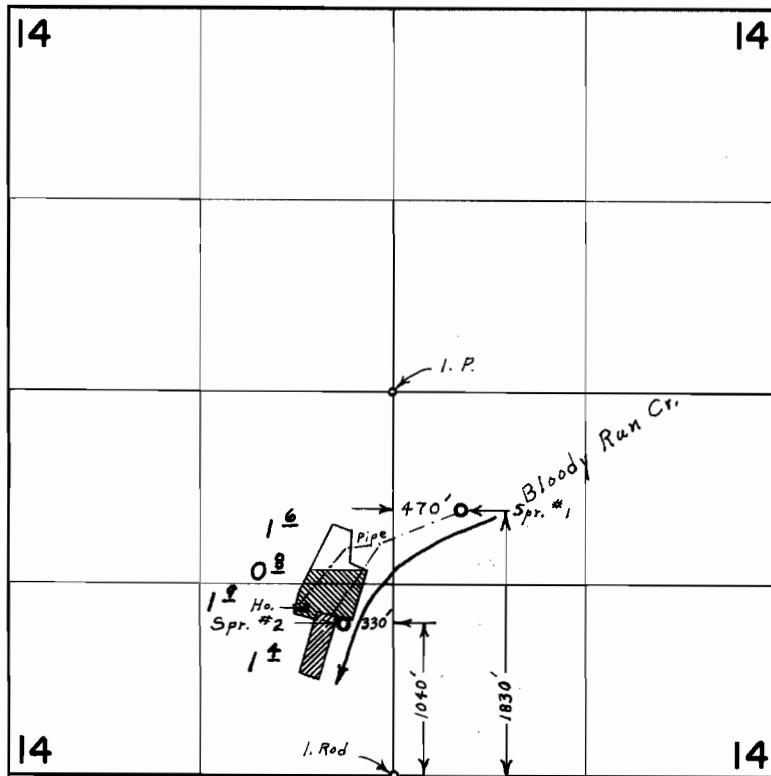

Irrig. from Spr. #1
 Irrig. from Spr. #2

FINAL PROOF SURVEY UNDER

Application No. 41686 Permit No. 31132
IN NAME OF

ROY J. & CLARA G. MORRISON

Surveyed Aug. 26, 1967., by L. E. Gould