


T. 36 S. R. 5 W. W. M.

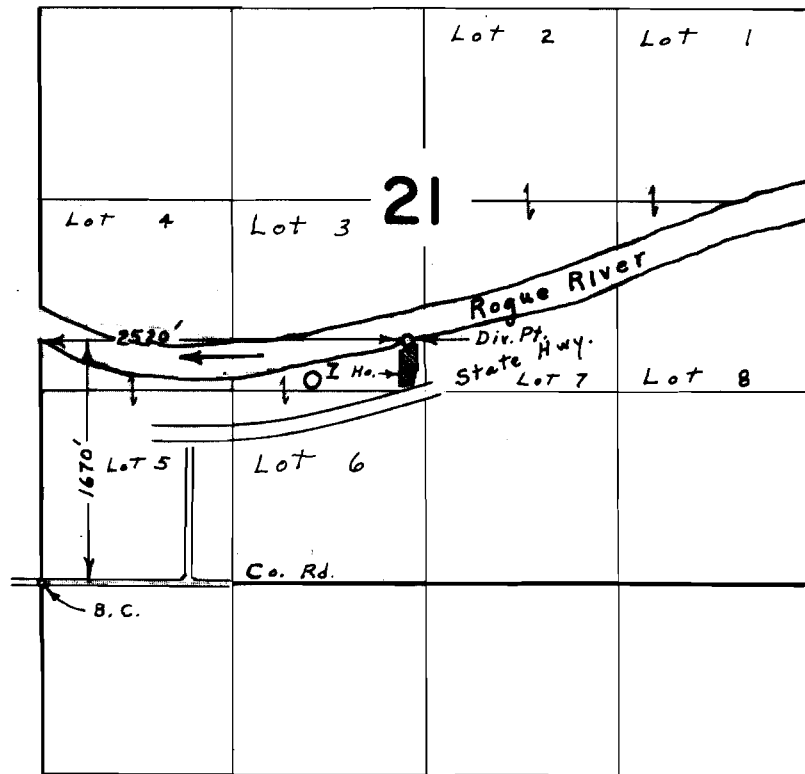

FINAL PROOF SURVEY UNDER

Application No. 41999... Permit No. 31960...
IN NAME OF

ERNEST F. KROEGER

Surveyed Aug. 24, 1967, by L. E. Gould...