


T.36S.R.5W.W.M.

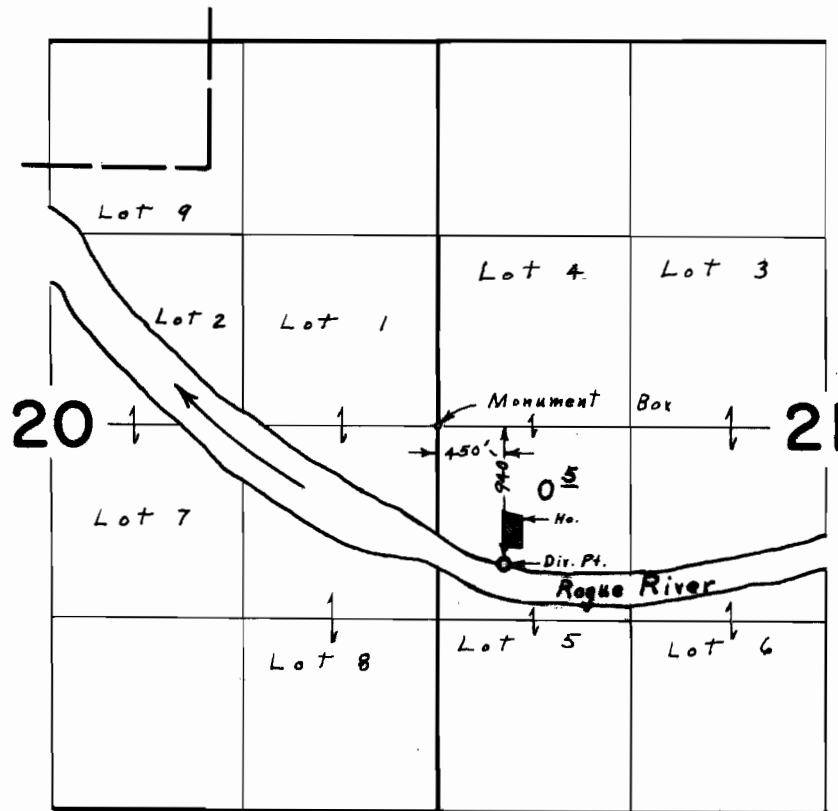

FINAL PROOF SURVEY UNDER

Application No. 42783 Permit No. 31985
IN NAME OF
J. A. FLOWER

Surveyed Aug. 24, 1967, by L. E. Gould