


T.17 S.R.5 W.W.M.

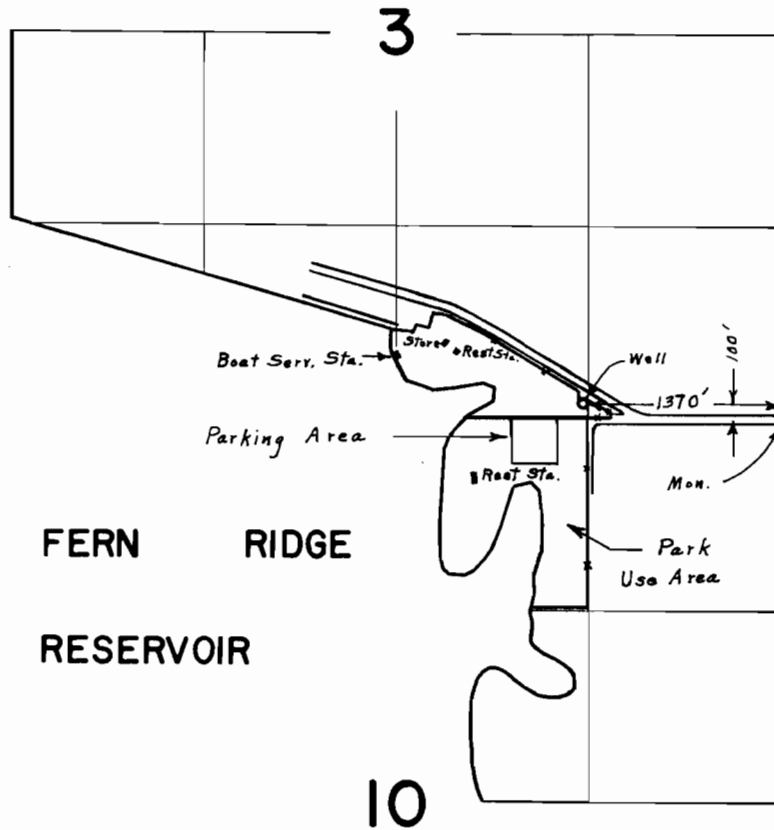

FINAL PROOF SURVEY
UNDER

Application No. G-2711 Permit No. G-2531
IN NAME OF
THE UNITED STATES OF AMERICA
CORPS OF ENGINEERS

Surveyed May 5, 1967, by L. E. Gould