


T.15S.R.4W.W.M.

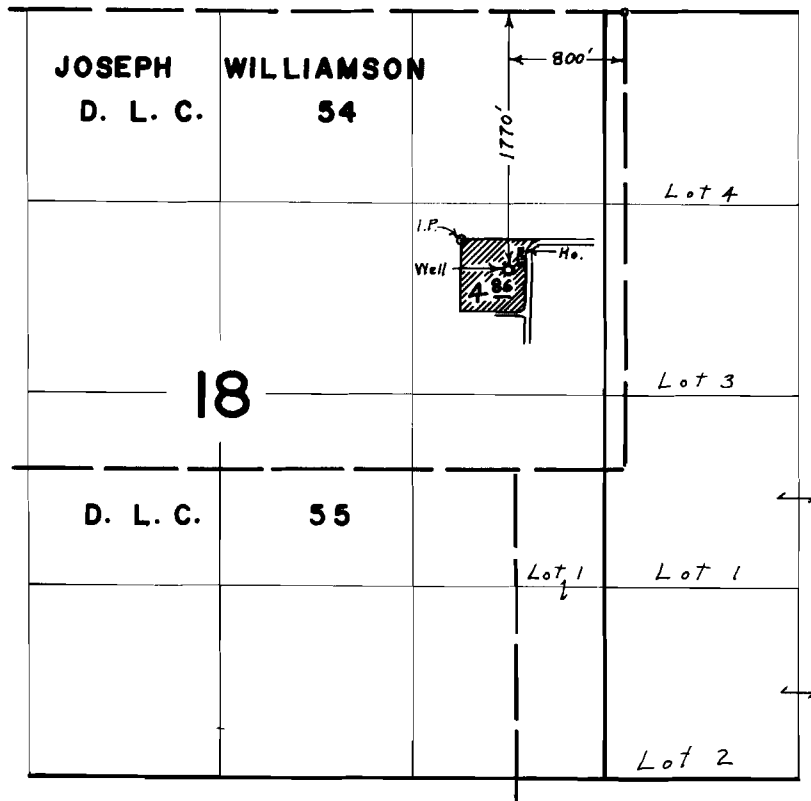

FINAL PROOF SURVEY UNDER

Application No. G-2933 Permit No. G-2743
IN NAME OF
HAROLD C. BATCH

Surveyed *April 27, 1967*, by *L. E. Gould*