


# T.15 S.R.4 W. W. M.

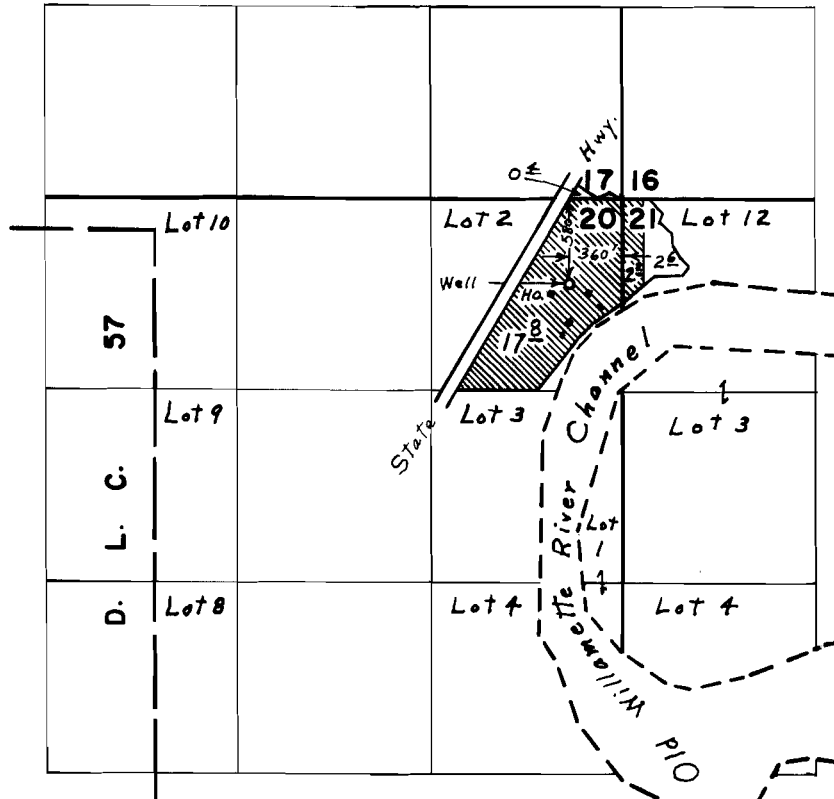

## FINAL PROOF SURVEY UNDER

Application No. G-2998 Permit No. G-2794  
IN NAME OF  
**RAYMOND KOLB**

Surveyed April 25, 1967, by L. E. Gould