


T.17S.R.4 & 5 W.W.M.

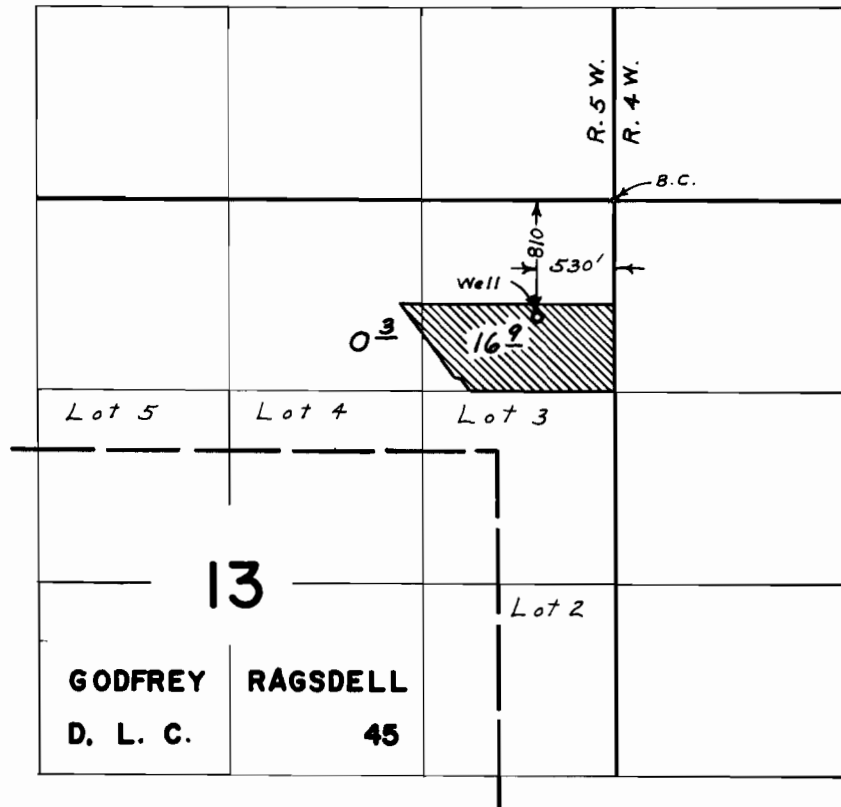

FINAL PROOF SURVEY
UNDER

Application No. G-3181 Permit No. G-2947
IN NAME OF
PAUL JONES

Surveyed May 5, 1967, by L. E. Gould