


T.16S.R.4W.W.M.

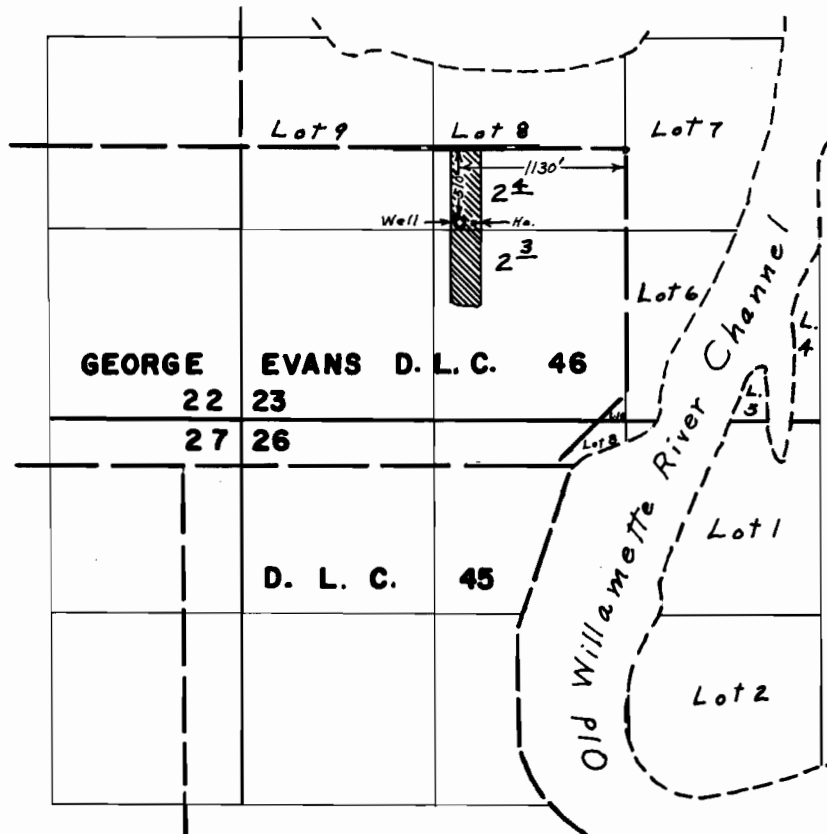

FINAL PROOF SURVEY UNDER

Application No. G-3357 Permit No. G-3150
IN NAME OF
ROBERT A. & MARGARET I. OLSON

Surveyed April 24, 1967, by L. E. Gould