


T.17S.R.6W.W.M.

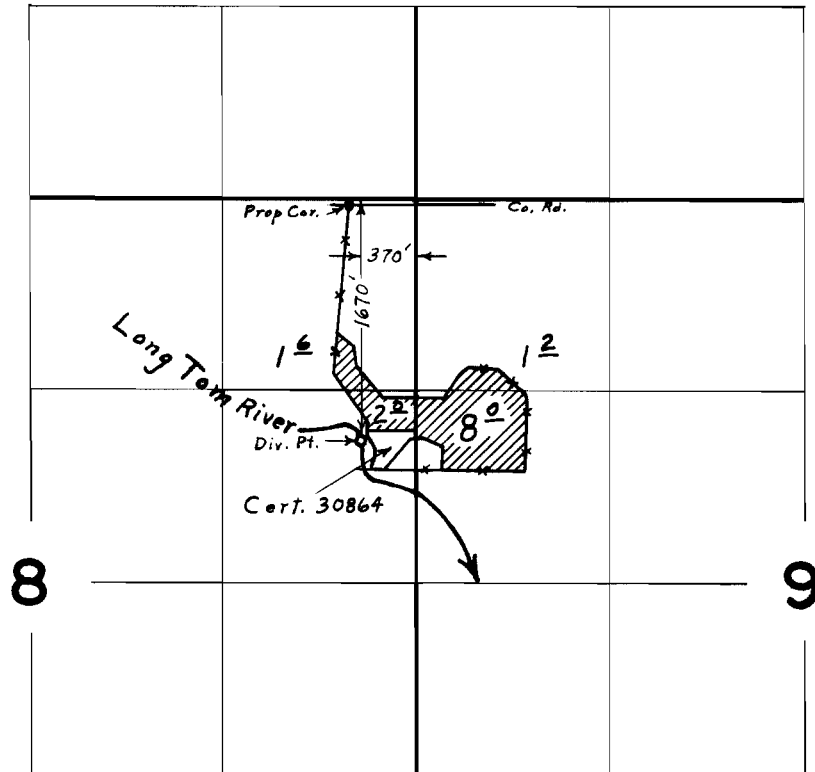

FINAL PROOF SURVEY UNDER

Application No. 38091 Permit No. 28557
IN NAME OF

KENNETH K. WARREN

Surveyed July 17, 1967, by L. E. Gould