


T.16S.R.6W.W.M.

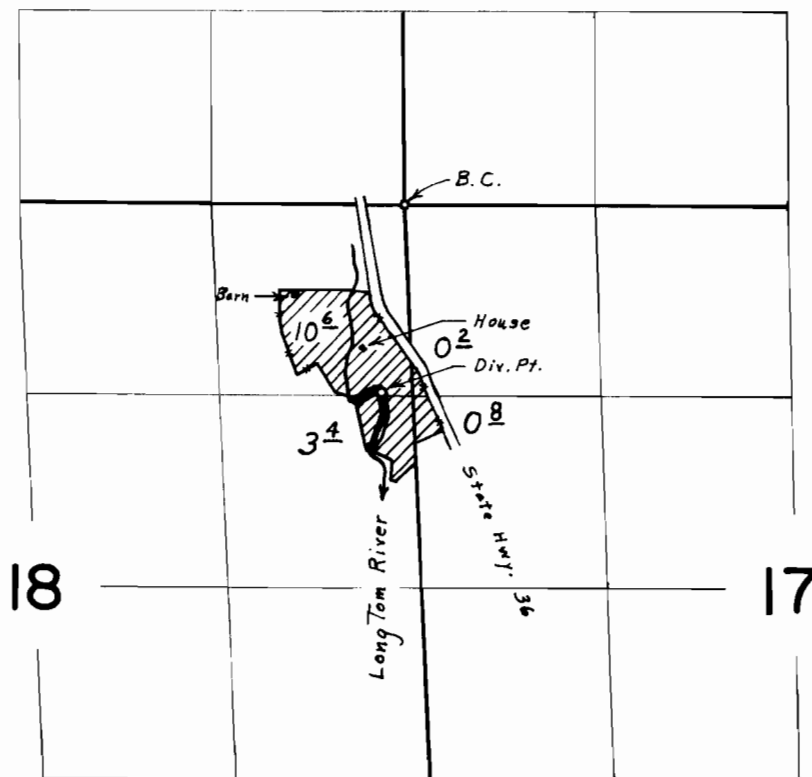

Div. Pt. located 1290' S. & 130' W. from N.E. Cor. Sec. 18

FINAL PROOF SURVEY
UNDER

Application No. 38741 Permit No. 28835
IN NAME OF
A C. HUBBARD

Surveyed May 10, 1967, by L. E. Gould