


T.15S.R.7 W.W.M.

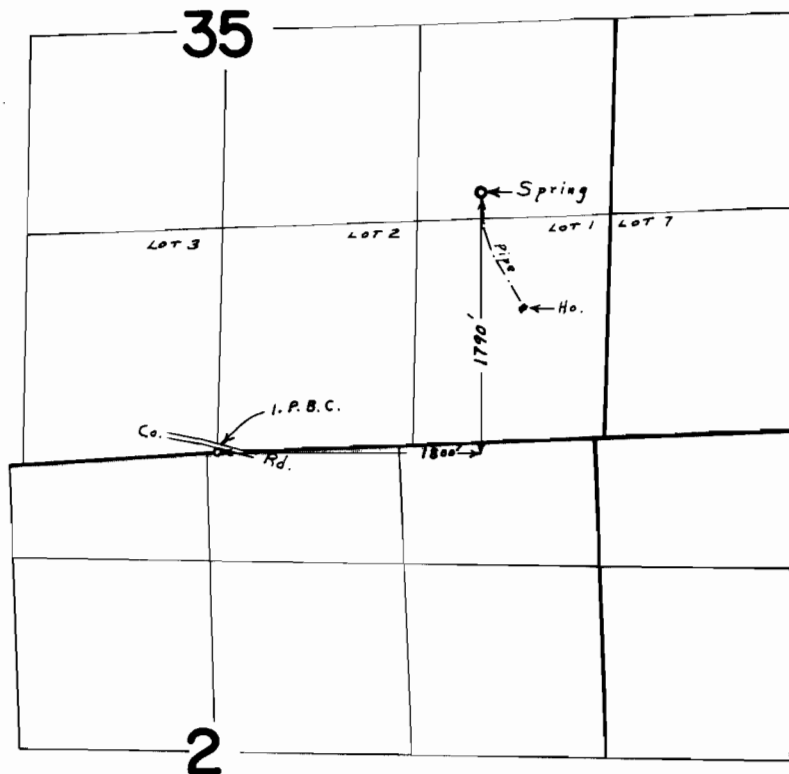

FINAL PROOF SURVEY
UNDER

Application No. 38048 Permit No. 29015
IN NAME OF
RAYMOND M. WOLFE

Surveyed July 18, 1967, by L. E. Gould