


T. 22 S. R. 3 W. W. M.

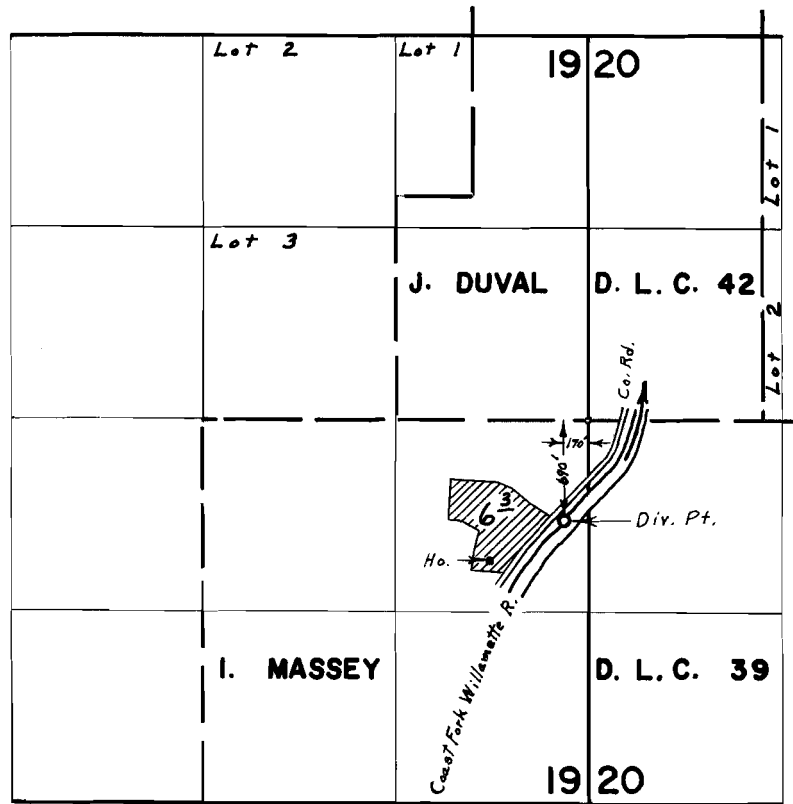

FINAL PROOF SURVEY
UNDER

Application No. 40797 Permit No. 30397
IN NAME OF

FRANCIS C. MAIN

Surveyed Sept 22, 1967, by L. E. Gould