


T.17S.R.5W.W.M.

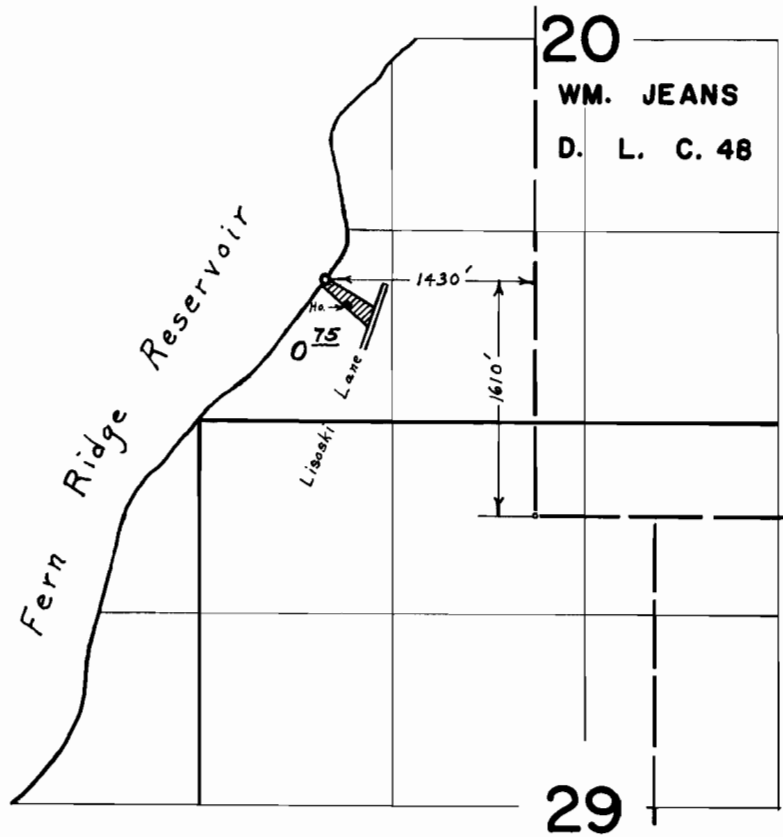

**FINAL PROOF SURVEY**  
UNDER

Application No. 41255 Permit No. 30970  
IN NAME OF

**JOHN J. & ESTHER LISOSKI**

Surveyed May 8, 1967, by L. E. Gould