


T. 7 S. R. 10 W. W. M.

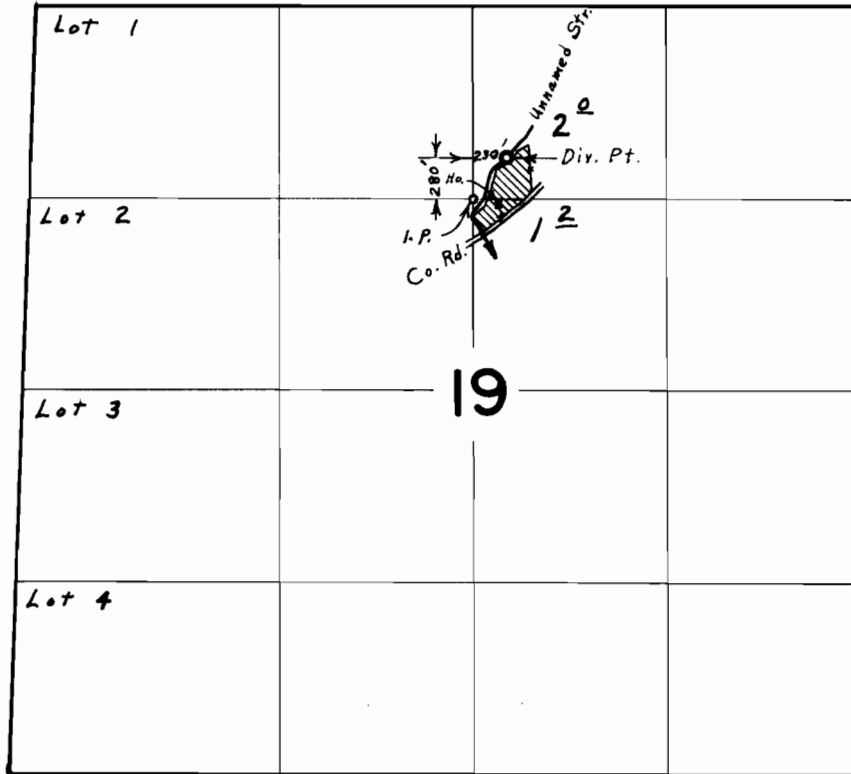

**FINAL PROOF SURVEY**  
UNDER

Application No. 38977 Permit No. 29041  
IN NAME OF

GLEN R. KINGSTON

Surveyed Sept. 26, 1967, by L. E. Gould