


T.10S.R.11W.W.M.

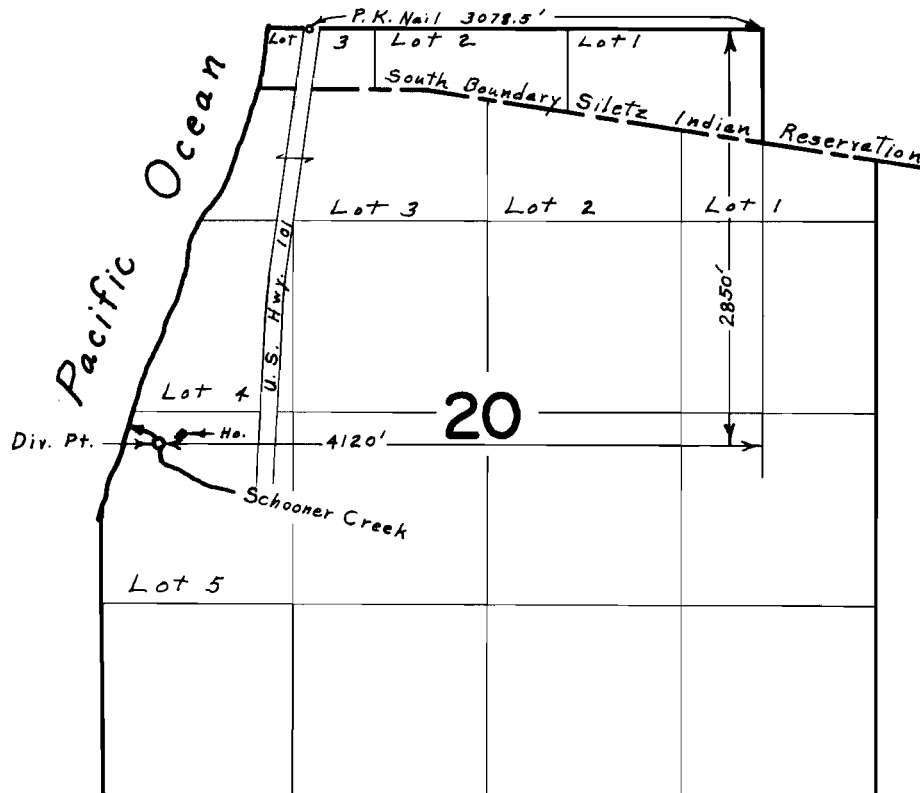

FINAL PROOF SURVEY
UNDER

Application No. 39078 Permit No. 29171
IN NAME OF

FRANK C. BOWERS, M. D.

Surveyed Sept. 28, 1967, by L. E. Gould