


T. 9 & 10 S. R. 10 W. W. M.

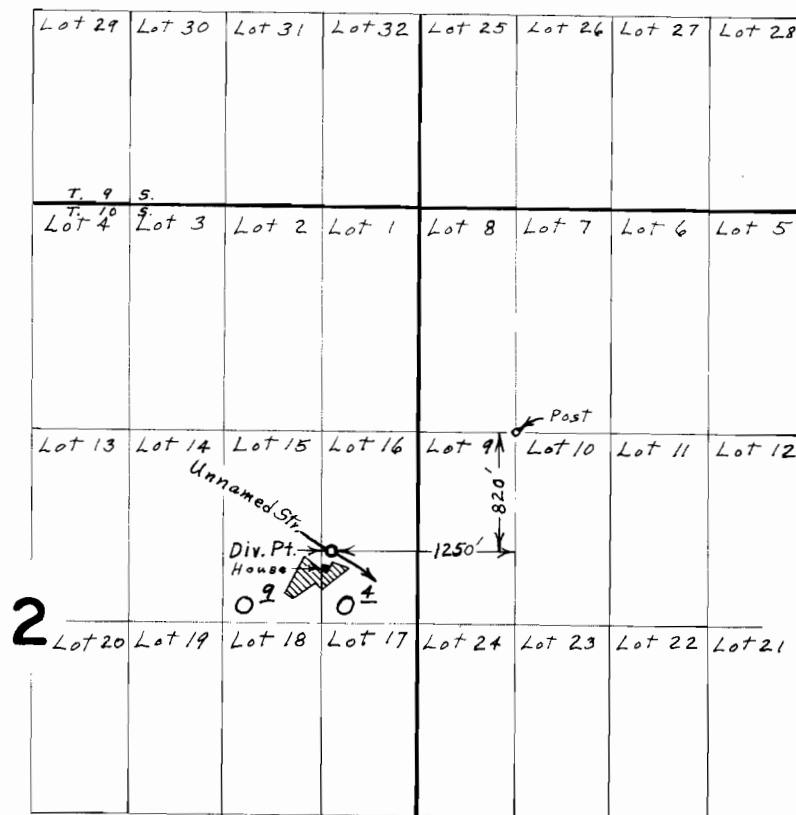

FINAL PROOF SURVEY UNDER

Application No. 39781 Permit No. 29890
IN NAME OF

HARRY ROSS MILLER

Surveyed Sept. 28, 1967, by L. E. Gould