


T. 6 & 7 S. R. 10 W. W. M.

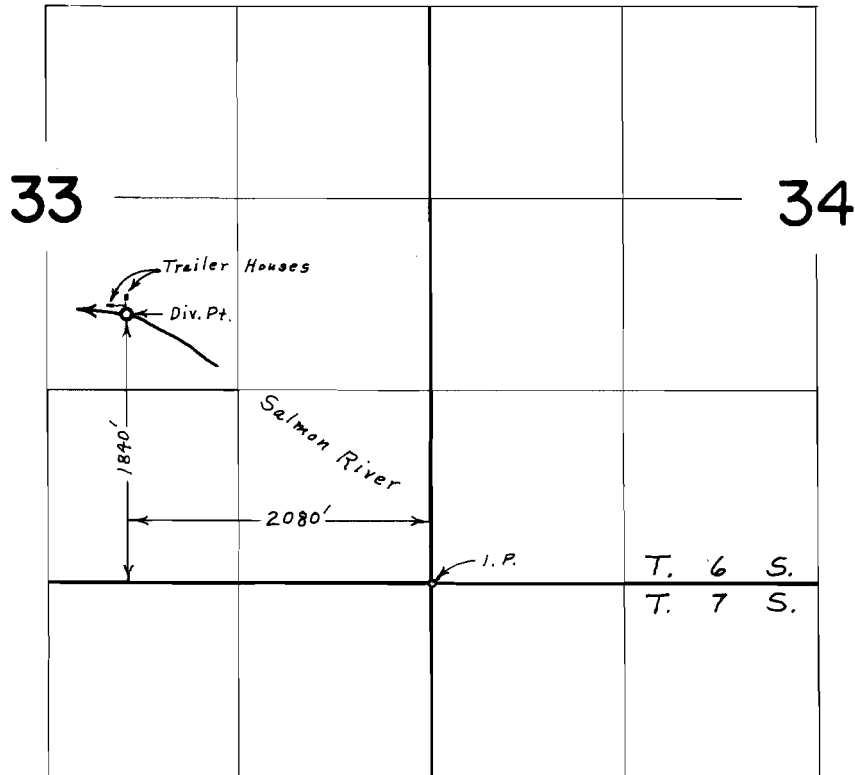

FINAL PROOF SURVEY UNDER

Application No. 40222 Permit No. 29999
IN NAME OF

W. M. OVERGARD

Surveyed Aug. 16, 1967, by L. E. Gould