


# T.7S.R.11W.W.M.

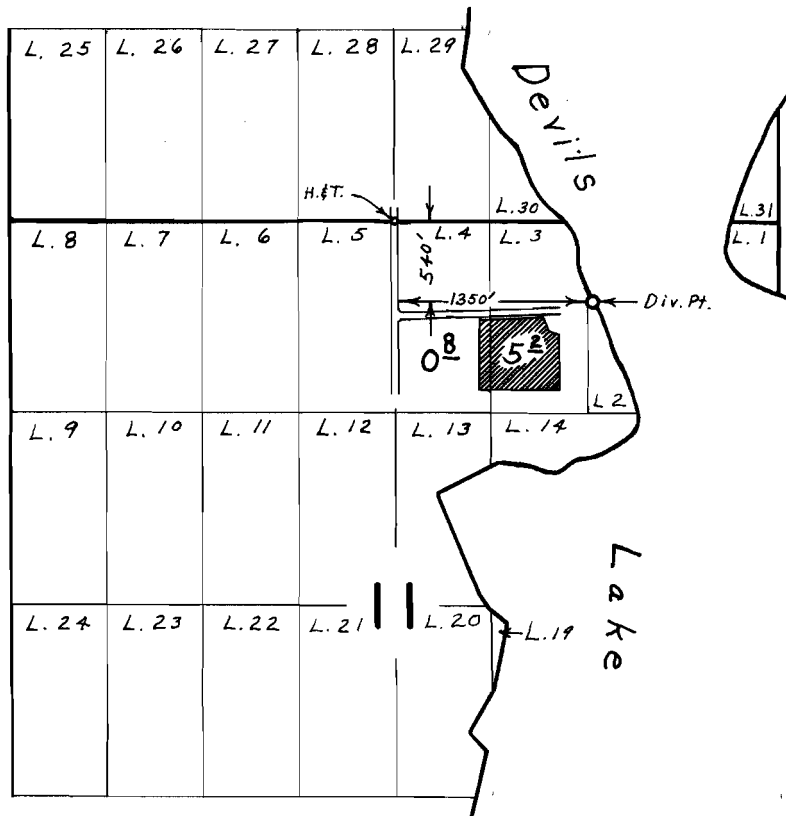

## FINAL PROOF SURVEY UNDER

Application No. 40774 Permit No. 30360  
IN NAME OF

**JAROLD BRYAN PARKS**

Surveyed Aug. 17. 1967. by L. E. Gould