


T. 7 S. R. 2 W. W.M.

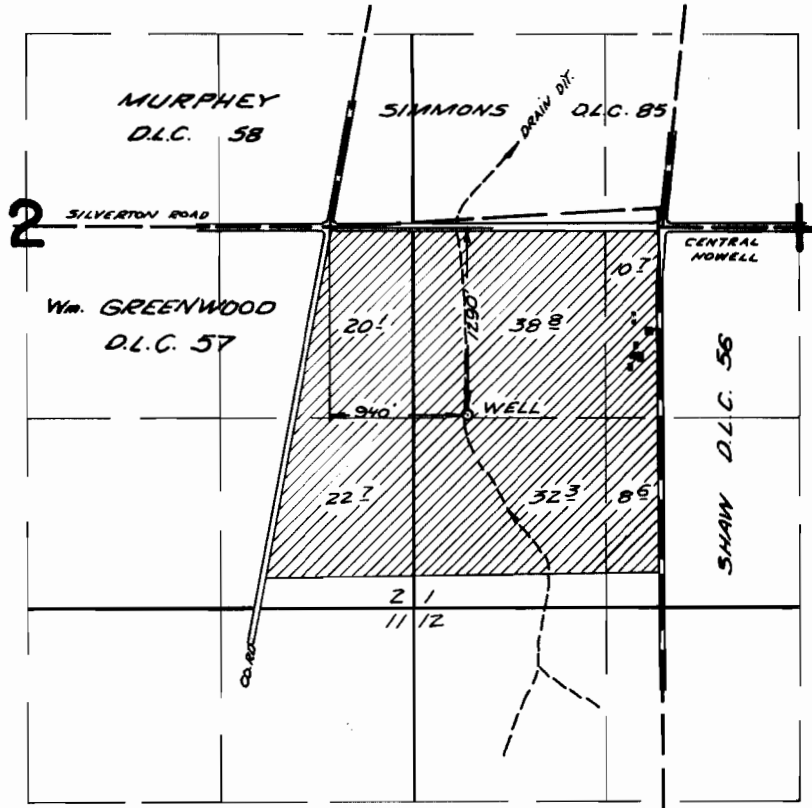

FINAL PROOF SURVEY
UNDER

Application No. G-3333 Permit No. G-3130
IN NAME OF

CECIL E. ROTH

Surveyed Nov. 21, 1967, by V. Garner