


T. 7 S. R. 1 E. W. M.

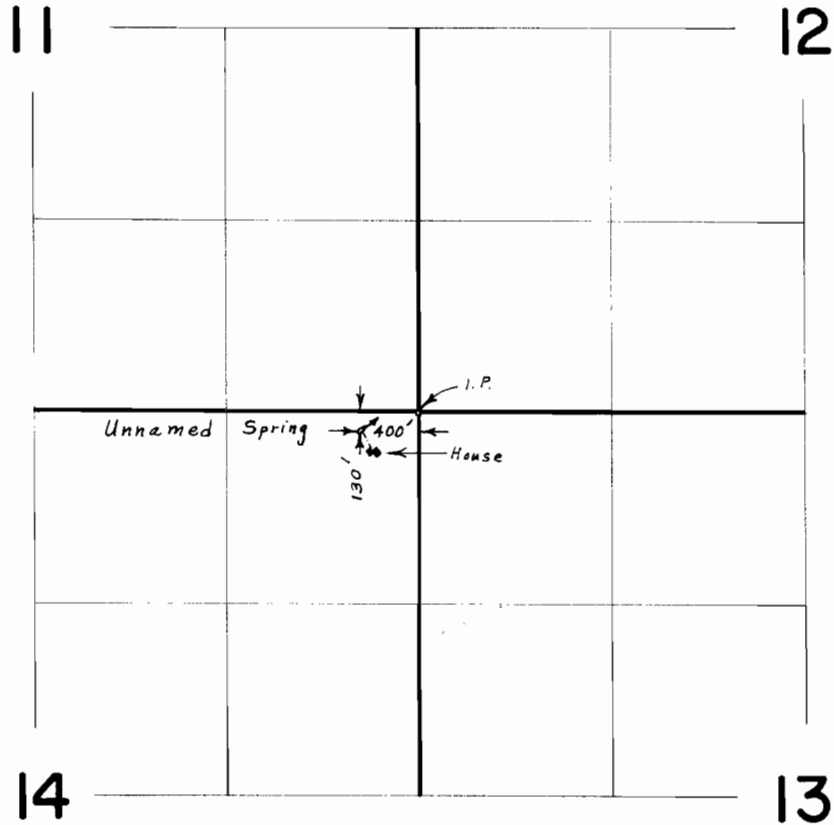

**FINAL PROOF SURVEY**  
UNDER

Application No. 34945 Permit No. 27409  
IN NAME OF

ELBERT C. & MARIAN E. MANOR

Surveyed Nov. 1, 1967, by Ralph Jackson