


T. 1 N., R. 2 E. W.M.

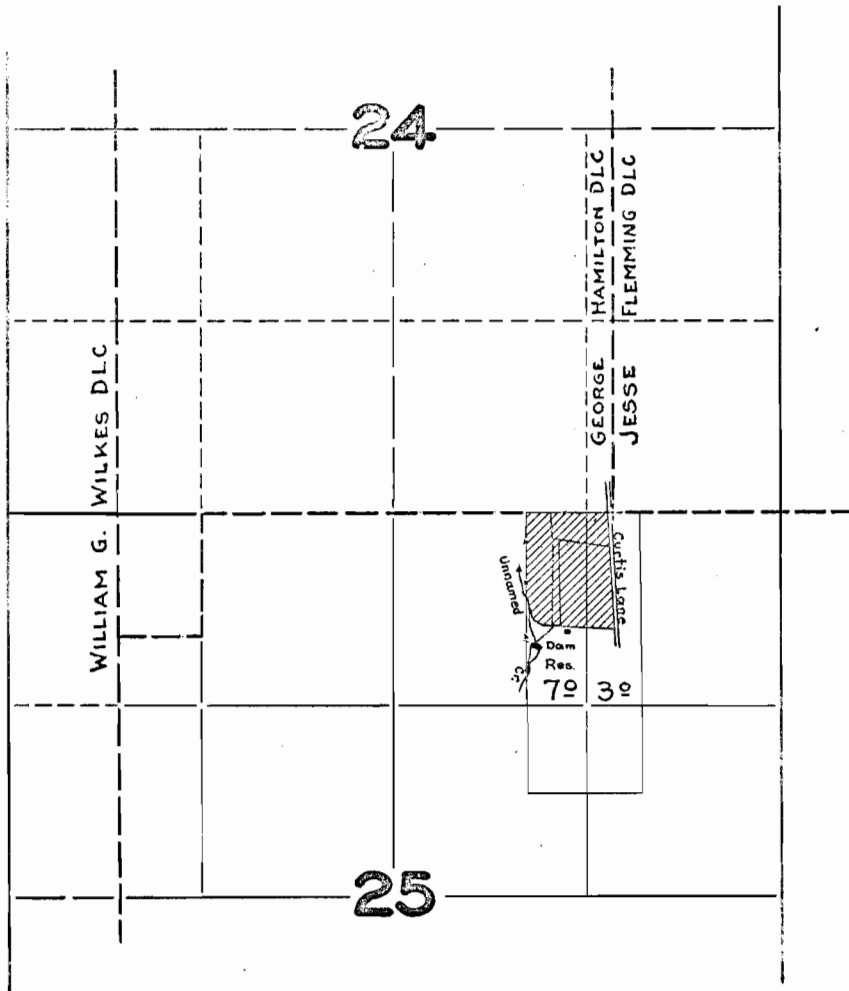

FINAL PROOF SURVEY

UNDER

Application No. 17578 Permit No. R-718  
17579 13276

IN NAME OF

Blair Holcomb, et al.

Surveyed July 30, 1942, by Scott Daderman