


T.4S. R.10W. W.M.

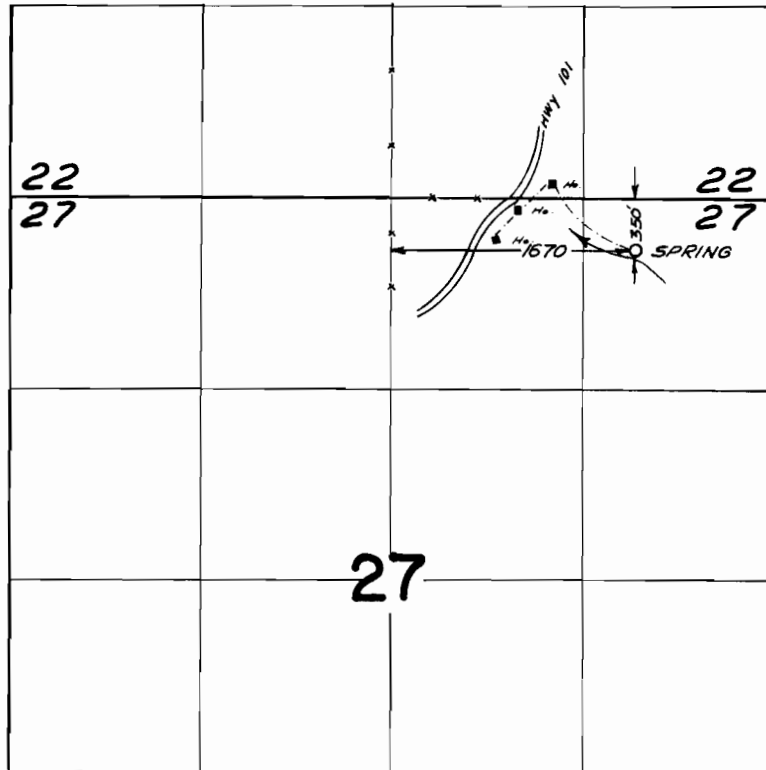

FINAL PROOF SURVEY UNDER

Application No. *42471*... Permit No. *31764*
IN NAME OF

MEADOW VIEW DAIRIES, INC.

Surveyed *Sept 26, 1967*, by *V. Garner*...