


T.4N.R.28E.W.M.

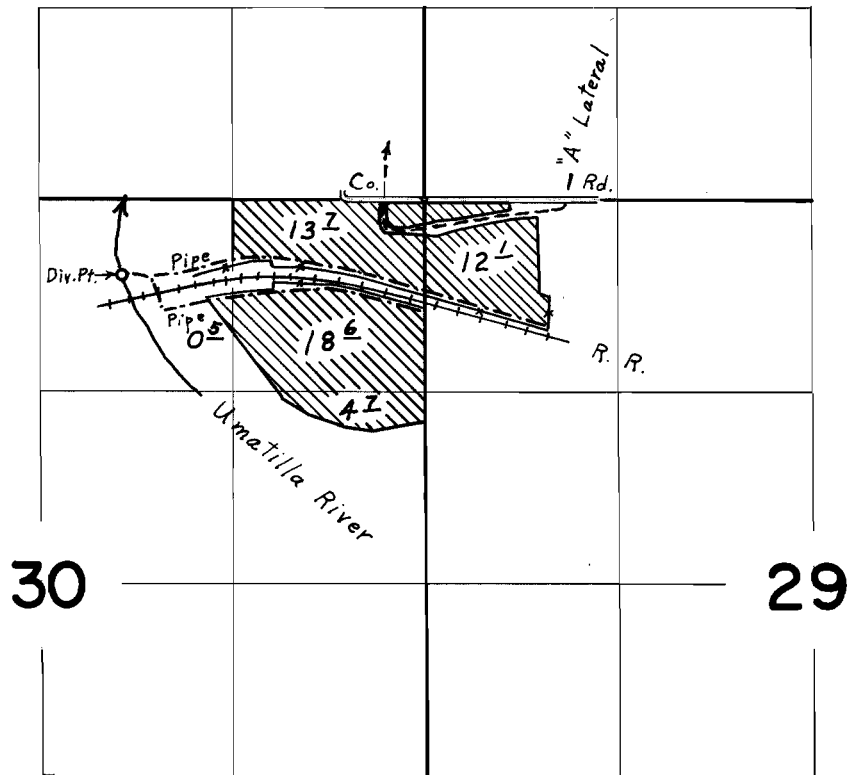

Div. Pt. located 520' S. & 2070' W. from the N.E. Cor. Sec. 30

FINAL PROOF SURVEY UNDER

Application No. 41608 Permit No. 31030
IN NAME OF
J. L. BACUS

Surveyed June 27, 1967, by L. E. Gould