


G-2647
29637

T.1&2 S. R.13E. W.M.

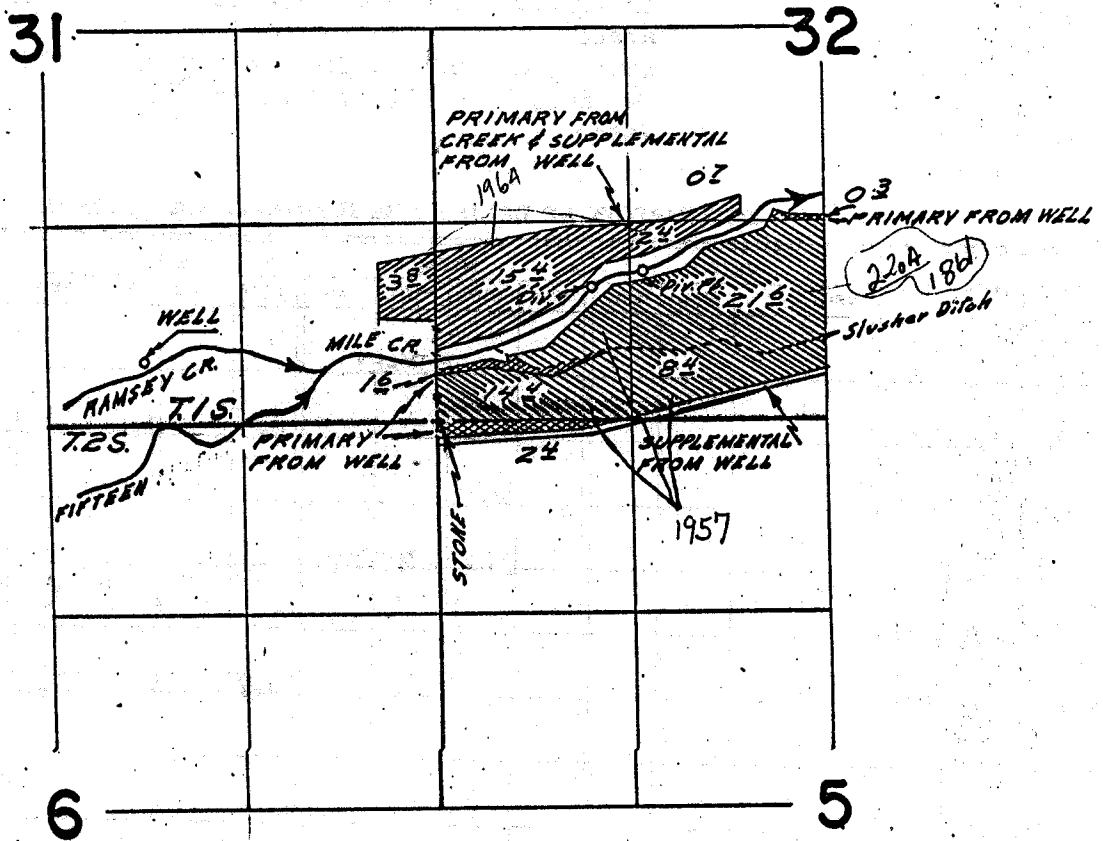

WELL LOCATED 400 FT. N. & 1980 FT. W.
 DIV. PTS. LOCATED 980 FT. N. & 1410 FT. E.
 870 FT. N. & 1060 FT. E.
 ALL FROM CORNER COMMON TO SEC. 31, 32, 6, & 6.

FINAL PROOF SURVEY UNDER

G-2839 G-2647
 Application No. ~~32758~~... Permit No. 29637
 IN NAME OF

WILLIAM L. HULSE

Surveyed June 15, 1967, by W. St. Ruppert