


G-2647
29637

T.18&2 S. R.13E. W.M.

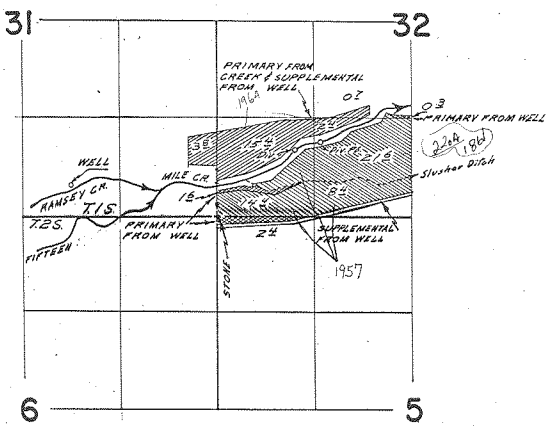

WELL LOCATED 400 FT. N & 1980 FT. W
 DIV. PTS. LOCATED 980 FT. N & 1410 FT. E
 870 FT. N & 1060 FT. E
 ALL FROM CORNER COMMON TO SEC. 31, 32, & 6.

FINAL PROOF SURVEY
 UNDER

G-2839 G-2647
 Application No. 22762... Permit No. 29637
 IN NAME OF

WILLIAM L. HULSE

Surveyed June 15, 1967, by W.L. Ruppert.