


# T. 1 S. R. 2 W. W. M.

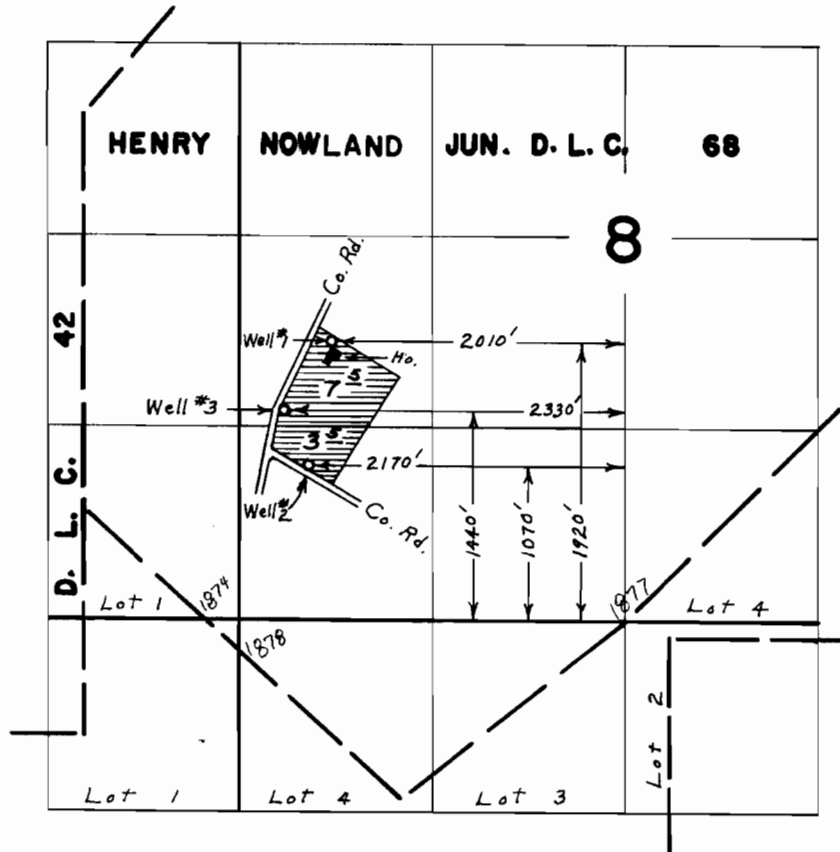

+ 1797

## FINAL PROOF SURVEY UNDER

Application No. G-3985 Permit No. G-3459  
IN NAME OF

**GLENN A. WALTERS**

Surveyed Sept. 15, 1967. by L. E. Gould.....